### **REQUEST FOR BIDS**

### ADDENDUM # 1

**Questions and Clarifications** 

#### Service Lane Renovation (General Contractor) IFB #FED2019-13

**TO:** Prospective Bidders

**FROM:** Martha Howarter, Director of Federal Programs

**DATE:** October 14, 2019

**SUBJECT:** Addendum No. 1 – Questions and Clarifications

The following is included as part of Addendum No.1 and supersedes the language/requirements set forth in the original "Request for Proposals".

### **ADDENDUM #1 – Questions and Clarifications**

Addendum No. 1 has been prepared by Farnsworth Group containing two (2) pages and nine (9) drawings related to the Service Lane Renovations.



Addendum Number: 01

**Project Name:** Service Lane Renovation

Project Number: 0180459.05

**Containing**: 2 Pages; 9 Drawings; 0 Specifications

This addendum amends the drawings and specifications of the above reference project and is hereby incorporated into the contract documents as part thereof. Bidders must acknowledge receipt of this Addendum in the space provided on the Bid Form. **FAILURE TO DO SO MAY SUBJECT BIDDER TO DISQUALIFICATION**.

#### General:

- 1. The General Contractor will be responsible for unloading and storing the bus wash equipment. Storage location to be onsite and coordinated with the Owner. Midwest Carwash will be responsible for setting the equipment in its final location within the service lane. General Contractor will be responsible for scheduling with Midwest Carwash. The General Contractor will not need to provide any anchor bolts for the bus wash equipment.
- 2. The extent of prep and painting for rooms noted on the Room Finish Schedule will be all exposed piping, hangers, un-insulated ductwork, conduit, structural steel, CMU walls, metal panel walls, and metal panel ceiling.
- 3. Existing corrugated fiberglass walls that are shown to be demolished will not be replaced.

#### **Drawings**:

- 1. ADD: Attached drawings S0.1, S1.1, & S1.2.
- 2. REPLACE: Drawing A1.0 FIRST FLOOR PLAN in its entirety with attached drawing A1.0.
- 3. REPLACE: Drawing E-101 FIRST FLOOR PLAN in its entirety with drawing E-101
- 4. REPLACE: Drawing E500 SCHEDULES in its entirety with the attached drawing E500 SCHEDULES.
- 5. REPLACE: Drawing E601 ONE LINE POWER DISTRIBUTION DIAGRAM in its entirety with attached drawing E601 ONE LINE POWER DISTRIBUTION DIAGRAM.
- 6. REPLACE: Drawing ED101 FIRST FLOOR DEMOLITION PLAN in its entirety with attached drawing E601 ONE LINE POWER DISTRIBUTION DIAGRAM.
- 7. REPLACE: Drawings M1.1 FIRST FLOOR MECHANICAL PLAN in its entirety with the attached M1.1 FIRST FLOOR MECHANICAL PLAN.

Bids are Due: October 31, 2019 / 2:00 PM local time at GPMTD PROCUREMENT, 2105 NE JEFFERSON AVENUE, PEORIA, ILLINOIS 61603-3535.

Farnsworth Group, Inc. Addendum Page 2 of 2

### Issued By:

FARNSWORTH GROUP, INC. Douglas Draeger Project Architect

#### Attachments:

Drawings: S0.1, S1.1, S1.2, A1.1, M1.1, ED-101, E-101, E-500, E-601

Specifications: None

THE CONTRACTOR SHALL HAVE SOLE RESPONSIBILITY FOR DETERMINING THE MEANS, METHODS, SEQUENCES, AND SAFETY PROCEDURES USED IN PERFORMING THE WORK. SHOULD THE ENGINEER VISIT THE SITE, IT IS IN THE CAPACITY AS ENGINEER AND NOT IN THE CAPACITY OF A CONTRACTOR.  REQUESTS FOR INFORMATION SHALL BE SUBMITTED TO THE ENGINEER UNLESS OTHERWISE NOTED.  THE CONTRACTOR IS TO ASSUME FULL RESPONSIBILITY, UNRELIEVED BY REVIEW OF SHOP DRAWINGS OR PERIODIC OBSERVATIONS, FOR COMPLIANCE WITH THE CONTRACT DOCUMENTS.  THE EXISTING CONDITIONS INDICATED ON THE DRAWINGS ARE BASED ON SITE MEASUREMENTS AS WELL AS ON MATERIAL PROVIDED BY THE OWNER AND NO CLAIM IS MADE AS TO ITS ABSOLUTE COMPLETENESS AND/OR ACCURACY PRIOR TO THE START OF CONSTRUCTION OPERATIONS.  WHERE NEW CONSTRUCTION ABUTS OR INTEGRATES WITH EXISTING CONSTRUCTION, THE CONTRACTOR SHALL VERIFIY THAT THE EXISTING CONSTRUCTION, THE CONTRACTOR SHALL VERIFIY THAT THE EXISTING CONDITIONS AND DIMENSIONS ARE CLOSE TO THOSE THAT HAVE BEEN ASSUMED. IF THERE ARE ANY VARIANCES THAT WILL PREVENT THE WORK FROM BEING COMPLETED IN ACCORDANCE WITH THE CONSTRUCTION DOCUMENTS, THEY SHALL BE REPORTED TO THE ENGINEER IMMEDIATELY UPON DISCOVERY. THE ENGINEER SHALL ADVISE THE CONTRACTOR AS TO THE NECESSARY MODIFICATIONS.  THE CONTRACTOR SHALL FAMILIARIZE HIMSELF WITH THE SCOPE OF THE WORK AND SOIL AND WATER CONDITIONS BEFORE PROCEEDING WITH THE WORK. THE ACTUAL CONDITIONS MAY VARY AT THE SITE.  THE CONTRACTOR SHALL NOTIFY THE ENGINEER IMMEDIATELY OF ANY DISCREPANCIES BETWEEN CONSTRUCTION DOCUMENTS AND ACTUAL FIELD CONDITIONS.  OVERIFY SIZE AND LOCATIONS OF HOLES AND SLEEVES THROUGH MASONRY WALLS AND CONCRETE SLABS WITH MECHANICAL AND PLUMBING CONTRACTORS.  1. GROUT BELOW BEAM BEARING SHALL BE IN PLACE AND PROPERLY CURED PRIOR TO ANY APPLICATION OF LOAD TO THE SUPPORTED MEMBER.  2. SEE ARCHITECTURAL DRAWINGS FOR:  • SIZE AND LOCATION OF STOREFRONT SYSTEMS, DOOR, AND WINDOW OPENINGS, EXCEPT AS SHOWN OR NOTED.  • FILODR AND ROF FINISHES, DRAINAGE, AND WATERPROOFING •	DEAD LOADS	3. MINIMUM CONCRETE COMPRESSIVE STRENGTH (F'C) AT 28 DAYS: SLABS ON GRADE	3. PROTECT CONCRETE FROM PHYSICAL DAMAGE OR REDUCED STRENGTH DUE TO WEATHER EXTREMES DURING MIXING, PLACING, AND CURING.  A. IN COLD WEATHER, COMPLY WITH ACI 305.  4. FINISH OF FORMED SLAB SURFACES:  A. SMOOTH-FORMED FINISH: PROVIDE A SMOOTH FINISH FOR CONCRETE SURFACES EXPOSED TO VIEW AND SURFACES TO BE COVERED WITH A COATING OR COVERING MATERIAL APPLIED DIRECTLY TO CONCRETE. REPAIR AND PATCH DEFECTIVE AREAS, WITH FINS AND OTHER PROJECTIONS COMPLETELY REMOVED AND SMOOTHED.  B. FLOAT FINISH: APPLY FLOAT FINISH TO MONOLITHIC SLAB SURFACES TO RECEIVE TROWEL FINISH WHEN SURFACE WATER HAS DISAPPEARED AND WHEN CONCRETE HAS STIFFENED SUFFICIENTLY TO PERMIT OPERATION OF POWER-DRIVEN FLOATS. CONSOLIDATE SURFACE WITH POWER-DRIVEN FLOATS OR BY HAND-FLOATING.  C. TROWEL FINISH: APPLY TROWEL FINISH TO MONOLITHIC SLAB SURFACES TO BE EXPOSED TO VIEW AND SLAB SURFACES TO BE COVERED WITH PAINT OR OTHER THIN FILM-FINISH COATING SYSTEM.  a. AFTER FLOATING, BEGIN FIRST TROWEL FINISH OPERATION USING A POWER-DRIVEN TROWEL. BEGIN FINAL TROWEL WHEN SURFACE PRODUCES A RINGING SOUND AS TROWEL IS MOVED OVER SURFACES D. CONSOLIDATE CONCRETE SURFACE BY FINAL HAND-TROWELING OPERATION, FREE OF TROWEL MARKS, UNIFORM IN TEXTURE AND APPEARANCE, AND WITH SURFACE LEVELED TO TOLERANCES OF F(F)20 (FLOOR FLATMESS) AND F(LI)7 (FLOOR LEVELNESS).  c. GRIND SMOOTH SURFACE DEFECTS THAT WOULD TELEGRAPH THROUGH APPLIED FLOOR COVERING SYSTEM.  5. CURING:  A. PROTECT FRESHLY PLACED CONCRETE FROM PREMATURE DRYING AND EXCESSIVE COLD OR HOT TEMPERATURE. IN HOT, DRY, AND WINDY WEATHER, APPLY AN EVAPORATION-CONTROL COMPOUND ACCORDING TO MANUFACTURER'S INSTRUCTIONS AFTER SCREEDING AND BULL FLOATING, BUT BEFORE POWER FLOATING AND TROWELING.  B. BEGIN INITIAL CURING AS SOON AS FREE WATER HAS DISAPPEARED FROM EXPOSED SURFACES.  C. CONTINUOUS FOG SPRAYING, CONTINUOUSLY WETTED ABSORPTIVE COVER, OR BY MOIST FOR NOT LESS THAN 7 DAYS.  D. APPLY MEMBRANE-FORMING CURING COMPOUND TO EXPOSED INTERIOR SLABS AND TO EXTERIORS ARE REMOVED. KEEP CONCRETE CONTINUOUSLY MOIST FOR NO	Engineers   Architects   Surve
STRUCTURAL STEEL  DIMENSIONS NOT SHOWN ON STRUCTURAL DRAWINGS.  SEE MECHANICAL, ELECTRICAL, AND PLUMBING DRAWINGS FOR:  PIPE RUNS, SLEEVES, TRENCHES, WALL AND SLAB OPENINGS, ETC., EXCEPT AS SHOWN OR NOTED.  ELECTRICAL CONDUIT RUNS, BOXES, OUTLETS IN WALLS AND SLABS.  CONCRETE INSERTS FOR ELECTRICAL, MECHANICAL, OR PLUMBING FIXTURES.  4. FOR PIPES EMBEDDED IN CMU:  A. CMU: PIPES SHALL NOT BE EMBEDDED IN CMU EXCEPT WHERE SPECIFICALLY DETAILED. CONDUITS MAY BE EMBEDDED IF ALL OF THE FOLLOWING ARE TRUE.  CONDUITS ARE <3/4" IN DIAMETER.  CONDUITS ARE NOT PLACED IN A CELL WITH REINFORCEMENT.  CONDUITS ARE A MINIMUM OF 24" FROM JAMB/END REINFORCEMENT IN FULLY GROUTED WALLS.  CELLS WITH CONDUITS ARE SPACED 32" O.C. MIN.  CONDUITS ARE VERTICAL	SITE CLASS = D SDS = 0.153 SD1 = 0.128 SEISMIC DESIGN CATEGORY = B  METAL DECK:  1. ALL METAL DECK SHALL BE DETAILED, FABRICATED, AND INSTALLED IN ACCORDANCE WITH THE CURRENT EDITION OF THE STEEL DECK INSTITUTE SPECIFICATIONS.	CONCRETE MIX DESIGN:  1. REINFORCED CONCRETE IS DESIGNED IN ACCORDANCE WITH AND SHALL BE PLACED IN COMPLIANCE WITH PROVISIONS OF THE FOLLOWING CODES, SPECIFICATIONS, AND STANDARDS:  A. ACI 304- RECOMMENDED PRACTICE FOR MEASURING, MIXING,	MANUFACTURER'S DIRECTIONS. RECOAT AREAS SUBJECTED TO HEAVY RAINFALL WITHIN 3 HOURS AFTER INITIAL APPLICATION. MAINTAIN CONTINUITY OF COATING AND REPAIR DAMAGE DURING CURING PERIOD.  E. USE MEMBRANE-CURING COMPOUNDS THAT WILL NOT AFFECT SURFACES TO BE COVERED WITH FINISH MATERIALS APPLIED DIRECTLY TO CONCRETE.  6. PROVIDE EQUIPMENT BASES AND SUPPORTS AS REQUIRED, COMPLYING WITH APPROVED MANUFACTURER'S CERTIFIED SHOP DRAWINGS OR AS DETAILED.  7. SIZE AND LOCATION OF CONCRETE BASES AND EMBEDDED ANCHORAGES FOR EQUIPMENT SHALL BE COORDINATED WITH EQUIPMENT SUPPLIER AND SHALL BE IN ACCORDANCE WITH APPROVED SHOP DRAWINGS.  CONCRETE TESTING  1. FIELD QUALITY CONTROL: THE OWNER WILL EMPLOY A TESTING AGENCY TO PERFORM TESTS AND TO SUBMIT TEST REPORTS. SAMPLING AND TESTING FOR QUALITY CONTROL DURING CONCRETE PLACEMENT. TESTING MAY INCLUDE THE FOLLOWING. AS DIRECTED BY THE STRUCTURAL ENGINEER.	
5. CONSTRUCTION MATERIAL SHALL NOT BE PLACED ON FRAMED ROOF OR RAISED FLOORS/LID.  6. THE CONTRACT STRUCTURAL DRAWINGS AND SPECIFICATIONS REPRESENT THE DESIGN INTENT FOR THE FINISHED STRUCTURE. THEY DO NOT INDICATE MEANS OR METHODS OF CONSTRUCTION. THE CONTRACTOR SHALL PROVIDE ALL MEASURES NECESSARY TO PROTECT THE STRUCTURE DURING CONSTRUCTION. SUCH MEASURES SHALL INCLUDE, BUT ARE NOT LIMITED TO, BRACING, SHORING FOR LOADS DUE TO CONSTRUCTION EQUIPMENT, ETC. THE CONTRACTOR IS RESPONSIBLE FOR PROVISIONS OF TEMPORARY SHORING AND OTHER CONSTRUCTION AIDS, INCLUDING ALL ENGINEERING OF SUCH SYSTEMS, FOR TEMPORARY SUPPORT OF NEW AND/OR EXISTING STRUCTURAL ELEMENTS AS REQUIRED FOR ERECTION AND OTHER CONTRACTOR'S MEANS AND METHODS OF CONSTRUCTION, UNLESS NOTED OTHERWISE. OBSERVATION VISITS TO THE SITE BY THE STRUCTURAL ENGINEER SHALL NOT INCLUDE INSPECTION OF THE ABOVE ITEMS.	<ol> <li>ALL METAL DECK SHALL BE CONTINUOUS OVER THREE OR MORE SUPPORTS UNLESS APPROVED BY THE ENGINEER.</li> <li>SEE FRAMING PLAN NOTES FOR METAL DECK ATTACHMENT. PROVIDE FRAME FASTENERS AT ALL DIAPHRAGM EDGES USING SIDELAP FASTENING SPACING.</li> <li>ALL METAL DECK SHALL BE GALVANIZED.</li> <li>METAL DECK OPENINGS UP TO 6" DO NOT REQUIRE REINFORCING AS LONG AS NOT MORE THAN TWO WEBS ARE REMOVED FROM THE DECK. FOR OPENINGS GREATER THAN 6" AND UP TO 12", THE DECK MUST BE REINFORCED WITH A MINIMUM 0.071" SHEET OF STEEL, 6" WIDER THAN THE OPENING ON EACH SIDE AND FASTED TO EACH CELL ALL AROUND THE OPENING. OPENINGS GREATER THAN 12" SHALL BE REINFORCED.</li> </ol>	TRANSPORTING, AND PLACING OF CONCRETE.  B. ACI 318- BUILDING CODE REQUIREMENTS FOR REINFORCED CONCRETE C. CONCRETE REINFORCING STEEL INSTITUTE (CRSI) "MANUAL OF STANDARD PRACTICE."  2. SUBMITTALS: INCLUDE SUBMITTALS AS REQUIRED BY SECTION 4 OF THE ACI 301.  3. CONCRETE MATERIALS: A. PORTLAND CEMENT SHALL CONFORM TO ASTM C150, TYPE I/II. B. NORMAL WEIGHT AGGREGATES SHALL CONFORM TO ASTM C33. C. PROVIDE AGGREGATE FROM SINGLE SOURCE. D. WATER: ANY POTABLE DRINKING WATER.  4. ADMIXTURES: A. AIR ENTRAINING ADMIXTURE SHALL CONFORM TO ASTM C260. B. WATER REDUCING ADMIXTURE SHALL CONFORM TO ASTM C494, TYPE A.  5. CONCRETE MIX DESIGNS: CLASS A CONCRETE- AIR ENTRAINED MEETING THE FOLLOWING REQUIREMENTS:	<ul> <li>A. SAMPLING FRESH CONCRETE: ASTM C 172, EXCEPT MODIFIED FOR SLUMP TO COMPLY WITH ASTM C 94.</li> <li>B. SLUMP: ASTM C 143, ONE TEST AT POINT OF DISCHARGE FOR EACH DAY'S POUR OF EACH TYPE OF CONCRETE; ADDITIONAL TESTS WHEN CONCRETE CONSISTENCY SEEMS TO HAVE CHANGED.</li> <li>C. AIR CONTENT: ASTM C 173, VOLUMETRIC METHOD FOR LIGHTWEIGHT OR, NORMAL WEIGHT CONCRETE; ASTM C 231, PRESSURE METHOD FOR NORMAL WEIGHT CONCRETE; ONE FOR EACH DAY'S POUR OF EACH TYPE OF AIRENTRAINED CONCRETE.</li> <li>D. CONCRETE TEMPERATURE: ASTM C 1064; ONE TEST HOURLY WHEN AIR TEMPERATURE IS 40 DEGREES F AND BELOW, WHEN 80 DEGREES F AND ABOVE, AND ONE TEST FOR EACH SET OF COMPRESSIVE STRENGTH SPECIMENS.</li> <li>E. COMPRESSION TEST SPECIMEN: ASTM C 31; ONE SET OF FOUR STANDARDS CYLINDERS FOR LABORATORY CURED TEST SPECIMENS EXCEPT WHEN FIELD-CURED TEST SPECIMENS ARE REQUIRED.</li> <li>F. COMPRESSIVE-STRENGTH TESTS: ASTM C 39; ONE SET FOR EACH DAY'S POUR EXCEEDING 50 CU. YD. PLUS ADDITIONAL SETS FOR EACH 100 CU. YD. MORE THAN THE FIRST 35 CU. YD. OF EACH CONCRETE PLACED IN ANY ONE</li> </ul>	
SHOP DRAWING REVIEW:  FARNSWORTH GROUP WILL REVIEW THE GENERAL CONTRACTOR'S SHOP DRAWINGS AND RELATED SUBMITTALS (AS INDICATED BELOW) WITH RESPECT TO THE ABILITY OF THE DETAILED WORK, WHEN COMPLETED, TO BE A PROPERLY FUNCTIONING INTEGRAL ELEMENT OF THE OVERALL STRUCTURAL SYSTEM DESIGNED BY FARNSWORTH GROUP.  PRIOR TO SUBMITTAL OF A SHOP DRAWING OR ANY RELATED MATERIAL TO FARNSWORTH GROUP, THE GENERAL CONTRACTOR SHALL:  A. REVIEW EACH SUBMISSION FOR CONFORMANCE WITH THE MEANS, METHODS, TECHNIQUES, SEQUENCES, AND OPERATIONS FOR CONSTRUCTION AND SAFETY PRECAUTIONS AND PROGRAMS INCIDENTAL THERETO, ALL OF WHICH ARE THE SOLE RESPONSIBILITY OF THE GENERAL CONTRACTOR.  B. REVIEW AND APPROVE EACH SUBMISSION.  C. STAMP EACH SUBMISSION AS APPROVED.  FARNSWORTH GROUP SHALL ASSUME THAT NO SUBMISSION COMPRISES A VARIATION UNLESS THE GENERAL CONTRACTOR ADVISES FARNSWORTH GROUP WITH WRITTEN DOCUMENTATION.	COLD FORMED METAL FRAMING:  1. STRUCTURAL COLD FORMED METAL (LIGHT - GAGE) FRAMING SHALL BE DESIGNED AND CONSTRUCTED IN ACCORDANCE WITH THE AISI "NORTH AMERICAN SPECIFICATION FOR THE DESIGN OF COLD-FORMED STEEL STRUCTURAL MEMBERS" CURRENT EDITION INCLUDING ANY SUPPLEMENTS.  2. ALL STRUCTURAL LIGHT-GAGE JOIST AND STUDS SHALL CONFORM TO THE FOLLOWING MINIMUM YIELD STRENGTH PER ASTM SPECIFICATIONS:  12, 14, 16 GAGE	A. SLUMP: 4" ± 1 B. MAXIMUM AGGREGATE SIZE: 3/4 INCH C. MAXIMUM W/C RATIO: 0.5 D. AIR CONTENT: AT SLABS IT SHALL BE <3%  6. CURING MATERIALS: A. LIQUID MEMBRANE-FORMING CURING COMPOUND SHALL CONFORM TO ASTM C309, CLASS A OR B, TYPE I.  7. RELATED MATERIALS: A. NONSHRINK GROUT SHALL BE NONMETALLIC. B. PROVIDE MOISTURE INTENSIVE, EPOXY-RESIN BONDING AGENT EQUAL TO EUCO EPOXY BY EUCLID CHEMICAL COMPANY. C. PROVIDE EXPANSION JOINT FILLERS: a. PREMOLDED CORK OF THICKNESS INDICATED AND CONFORMING TO ASTM D1752, TYPE II CORK WITH A POLYETHYLENE STRIP BOND BREAKER. b. TWO COMPONENT POLYSULFIDE SYSTEM EQUAL TO SIKAFLEX POLYSULFIDE SEALANT BY SIKA CHEMICAL COPORATION.	DAY; ONE SPECIMEN RETAINED IN RESERVE FOR LATER TESTING IF REQUIRED.  2. WHEN FREQUENCY OF TESTING WILL PROVIDE FEWER THAN FIVE STRENGTH TESTS FOR A GIVEN CLASS OF CONCRETE, CONDUCT TESTING FROM AT LEAST FIVE RANDOMLY SELECTED BATCHES OR FROM EACH BATCH IF FEWER THAN FIVE ARE USED.  3. WHEN TOTAL QUANTITY OF A GIVEN CLASS OF CONCRETE IS LESS THAN 50 CU. YD., STRUCTURAL ENGINEER MAY WAIVE STRENGTH TESTING IF ADEQUATE EVIDENCE OF SATISFACTORY STRENGTH IS PROVIDED.  4. WHEN STRENGTH OF FIELD-CURED CYLINDERS IS LESS THAN 85 PERCENT OF COMPANION LABORATORY-CURED CYLINDERS, EVALUATE CURRENT OPERATIONS AND PROVIDE CORRECTIVE PROCEDURES FOR PROTECTING AND CURING THE INPLACE CONCRETE.  5. STRENGTH LEVEL OF CONCRETE WILL BE CONSIDERED SATISFACTORY IF AVERAGES OF ALL SETS OF THREE CONSECUTIVE STRENGTH TEST RESULTS EQUAL OR EXCEED SPECIFIED COMPRESSIVE STRENGTH AND NO INDIVIDUAL STRENGTH TEST RESULT FALLS BELOW SPECIFIED COMPRESSIVE STRENGTH BY MORE THAN 500 PSI.	
SHOP DRAWINGS AND RELATED MATERIAL (IF ANY) REQUIRED ARE INDICATED BELOW. SHOULD FARNSWORTH GROUP REQUIRE MORE THAN TEN (10) WORKING DAYS TO PERFORM THE REVIEW, FARNSWORTH GROUP SHALL SO NOTIFY THE GENERAL CONTRACTOR.  A. CONCRETE DESIGN MIXES AND REINFORCING STEEL. B. MISCELLANEOUS ANCHORS SHOWN ON THE STRUCTURAL DRAWINGS. C. STRUCTURAL STEEL FRAMING AND CONNECTIONS. D. LIGHT GAGE FRAMING AND CONNECTIONS. E. METAL DECK  ONLY TWO REVIEWS PER SHOP DRAWING SHALL BE ALLOWED. ANY SUBSEQUENT REQUIRED REVIEWS OF THE SAME SHOP DRAWING SHALL BE AT THE COST OF THE CONTRACTOR.			<ol> <li>TEST RESULTS WILL BE REPORTED IN WRITING TO STRUCTURAL ENGINEER, STRUCTURAL DESIGNER, READY-MIX PRODUCER, AND CONTRACTOR WITHIN 24 HOURS AFTER TEST REPORTS OF COMPRESSIVE STRENGTH TESTS. REPORTS OF COMPRESSIVE STRENGTH TESTS SHALL CONTAIN THE PROJECT IDENTIFICATION NAME, DATE OF CONCRETE PLACEMENT, NAME OF CONCRETE TESTING SERVICE, CONCRETE TYPE AND CLASS, LOCATION OF CONCRETE BATCH IN STRUCTURE, DESIGN COMPRESSIVE STRENGTH AT 28 DAYS, CONCRETE MIX PROPORTIONS AND MATERIALS, COMPRESSIVE BREAKING STRENGTH, AND TYPE OF BREAK FOR BOTH 7-DAY TESTS AND 28-DAY TESTS.</li> <li>NONDESTRUCTIVE TESTING: IMPACT HAMMER, SONOSCOPE, OR OTHER NONDESTRUCTIVE DEVICE MAY BE PERMITTED BUT SHALL NOT BE USED AS THE SOLE BASIS FOR ACCEPTANCE.</li> </ol>	BID SET 10/01/201 PROJECT: Greater Peoria Mass To
	STEEL:  1. STRUCTURAL STEEL IS DESIGNED IN ACCORDANCE WITH AND SHALL BE CONSTRUCTED IN COMPLIANCE WITH THE AISC "SPECIFICATION FOR STRUCTURAL STEEL BUILDINGS," AND THE AISC "STEEL CONSTRUCTION MANUAL".  2. ALL STRUCTURAL STEEL, UNLESS OTHERWISE NOTED, SHALL CONFORM TO THE FOLLOWING ASTM SPECIFICATIONS:  W-SHAPES	MASONRY:  1. ENGINEERED MASONRY DESIGNED IN ACCORDANCE WITH THE "BUILDING CODE REQUIREMENTS FOR MASONRY STRUCTURES" (ACI 530/ASCE 5/TMS 402) BY THE AMERICAN CONCRETE INSTITUTE, THE AMERICAN SOCIETY OF CIVIL ENGINEERS, AND THE MASONRY SOCIETY.  2. DESIGN COMPRESSIVE STRENGTH OF MASONRY UNITS (F'm):  CONCRETE MASONRY		CityLink Service Remodel
	3. ALL BOLTED CONNECTIONS FOR STRUCTURAL STEEL SHALL CONFORM TO AISC "SPECIFICATION FOR STRUCTURAL JOINTS USING ASTM A325 OR A490 BOLTS".  4. UNLESS OTHERWISE SHOWN OR NOTED ON THE DRAWINGS, ALL BOLTED CONNECTIONS SHALL BE MADE WITH 3/4" DIAMETER HIGH STRENGTH BOLTS, BEARING TYPE WITH THREADS IN THE SHEAR PLANE, CONFORMING TO ASTM A325-N.  5. ALL WELDED CONNECTIONS FOR STRUCTURAL STEEL SHALL CONFORM TO AWS "STRUCTURAL WELDING CODE," D1.1.  6. UNLESS OTHERWISE SHOWN OR NOTED ON THE DRAWINGS, ALL WELDED CONNECTIONS SHALL BE MADE WITH E70-XX LOW HYDROGEN ELECTRODES.  7. PROVIDE ALL BOLT HOLES, STUDS, ANCHORS, AND CLIP ANGLES REQUIRED TO ATTACH OTHER MATERIALS AS SHOWN ON THE DRAWINGS.	TYPE S MORTAR ASTM C270 1800 PSI GROUT ASTM C476 2500 PSI  4. BOND BEAMS AND ALL VERTICAL REINFORCEMENT: A. NEW BILLET STEEL COMPLYING WITH ASTM A615 AND HAVING MINIMUM YIELD STRENGTH OF 60,000 PSI. B. REINFORCE FIRST CELL ADJACENT TO ALL OPENINGS UNDER LINTELS USING SAME SIZE BAR AS INDICATED FOR WALL REINFORCING. C. LAP DOWELS PROJECTING FROM FOUNDATION OR SLAB. D. GROUT REINFORCED CELLS SOLID. E. WHERE BOND BEAMS ARE CONTINUOUS AT CORNERS, PROVIDE CORNER BARS WITH MINIMUM 40 BAR DIAMETER LAP SPLICE ON EACH LEG. F. BOND BEAMS SHALL BE CONTINUOUS ACROSS VERTICAL CONTROL JOINTS.  5. BED JOINT REINFORCEMENT: A. CONTINUOUS HORIZONTAL WIRE TIES SHALL BE PLACED SUCH THAT THE DISTANCE BETWEEN THE FACE OF THE MASONRY WALL AND THE PARALLEL WIRE IS NOT MORE THAN ONE INCH. THE PARALLEL WIRES SHALL CONFORM TO ASTM A82 AND HAVE A MINIMUM YIELD STRESS OF 70.0 KSI. B. SINGLE WYTHE BLOCK:		2105 NE Jefferson Street Peoria, IL 61603  DATE: DESIGNED: DRAWN: REVIEWED:
	NOTED ON STRUCTURAL DRAWINGS. FOR NON-BEARING WALLS, PROVIDE LINTELS FOR ALL OPENINGS AND RECESSES NOT OTHERWISE DETAILED OR SCHEDULED AS FOLLOWS:  A. (1) L5x3 1/2x5/16 FOR EACH 4" OF MASONRY WIDTH W/ A MAX SPAN OF 8'-0"  B. PL5/16 x MASONRY WIDTH LESS 1" FOR SPANS OF LESS THAN 2'-0"  9. PROVIDE MINIMUM 8" BEARING FOR BEAMS OR LINTELS WITH SPANS 4'-0" OR LARGER AND 6" BEARING ON SPANS LESS THAN 4'-0", UNLESS OTHERWISE DETAILED ON THE DRAWINGS.  10. ANCHOR BOLTS SHALL CONFORM TO ASTM A307 AND SHALL BE PLACED WITHIN THE FOLLOWING TOLERANCES:  TOP OF ANCHOR BOLT ELEVATION	<ul> <li>a. 2-#9 GAGE DEFORMED WIRES, (1) AT EACH FACE SHELL, TRUSS TIED.</li> <li>C. BED JOINT REINFORCEMETN CLEAR COVER: <ul> <li>a. EXTERIOR FACE (EXPOSED TO ELEMENTS): 5/8" MIN</li> <li>b. INTERIOR FACE: 1/2" MIN</li> </ul> </li> <li>6. USE LIGHTWEIGHT CONCRETE MASONRY UNITS ABOVE GRADE UNLESS OTHERWISE SHOWN OR NOTED.</li> <li>7. BEARING FOR BEAMS, LINTELS, JOISTS, ETC., SHALL BE SOLID MASONRY UNITS OR HOLLOW MASONRY UNITS WITH CORES SLUSHED SOLID WITH GROUT. SEE TYPICAL DETAILS.</li> <li>8. UNLESS OTHERWISE SHOWN OR NOTED, REINFORCING STEEL SHALL BE LAPPED 40 BAR DIAMETERS, MINIMUM.</li> </ul>		GENERAL STRUCTURAL
	A. WHERE PROHIBITED BY THE REQUIREMENTS OF THE "SPECIFICATION FOR STRUCTURAL JOINTS" USING ASTM A325 BOLTS.  B. WHERE INDICATED TO BE GALVANIZED.  C. WHERE OTHERWISE NOTED ON PLANS AND DETAILS.			<b>S0.</b>

STRUCTURAL CONCRETE:

1. REINFORCED CONCRETE DESIGNED IN ACCORDANCE WITH THE "BUILDING CODE REQUIREMENTS FOR REINFORCED CONCRETE" (ACI 318) BY THE AMERICAN CONCRETE INSTITUTE.

2. REINFORCING BAR DETAILING, FABRICATING, AND PLACING SHALL CONFORM TO

THE CONCRETE REINFORCING STEEL INSTITUTE'S "REINFORCING BAR DETAILING"
AND "PLACING REINFORCING BARS".

**CONCRETE PLACEMENT** 

CONCRETE PLACEMENT: COMPLY WITH ACI 304, FOR PLACING CONCRETE IN A CONTINUOUS OPERATION WITHIN PLANNED JOINTS OR SECTIONS. DO NOT BEGIN CONCRETE PLACEMENT UNTIL OTHER AFFECTED WORK IS COMPLETED.

2. CONSOLIDATE PLACED CONCRETE USING MECHANICAL VIBRATING EQUIPMENT WITH HAND RODDING AND TAMPING SO THAT CONCRETE IS WORKED AROUND

REINFORCEMENT AND OTHER EMBEDDED ITEMS AND INTO FORMS.

**GENERAL CONSTRUCTION:** 

ALL DETAILS, SECTIONS, AND PLAN NOTES SHOWN ON THE DRAWINGS ARE INTENDED TO BE TYPICAL AND SHALL BE CONSTRUED TO APPLY TO SIMILAR CONDITIONS ELSEWHERE.

2. THE CONTRACTOR SHALL VERIFY, BY FIELD CHECK, ALL SIZES, DIMENSIONS, ELEVATIONS, LOCATIONS, ETC., OF THE EXISTING CONSTRUCTION WHICH ARE RELATIVE TO THE CONSTRUCTION.


**DESIGN CRITERIA:** 


INTERNATIONAL BUILDING CODE - 2012


1. THE STRUCTURAL ENGINEERING DESIGN IS BASED ON AND IN ACCORDANCE WITH THE FOLLOWING CODE:

2. UNLESS OTHERWISE SHOWN OR NOTED ON THE DRAWINGS, THE STRUCTURAL DESIGN IS BASED ON THE FOLLOWING TYPICAL UNIFORM LOADS:

10/01/2019 DESIGNER DRAWN BY

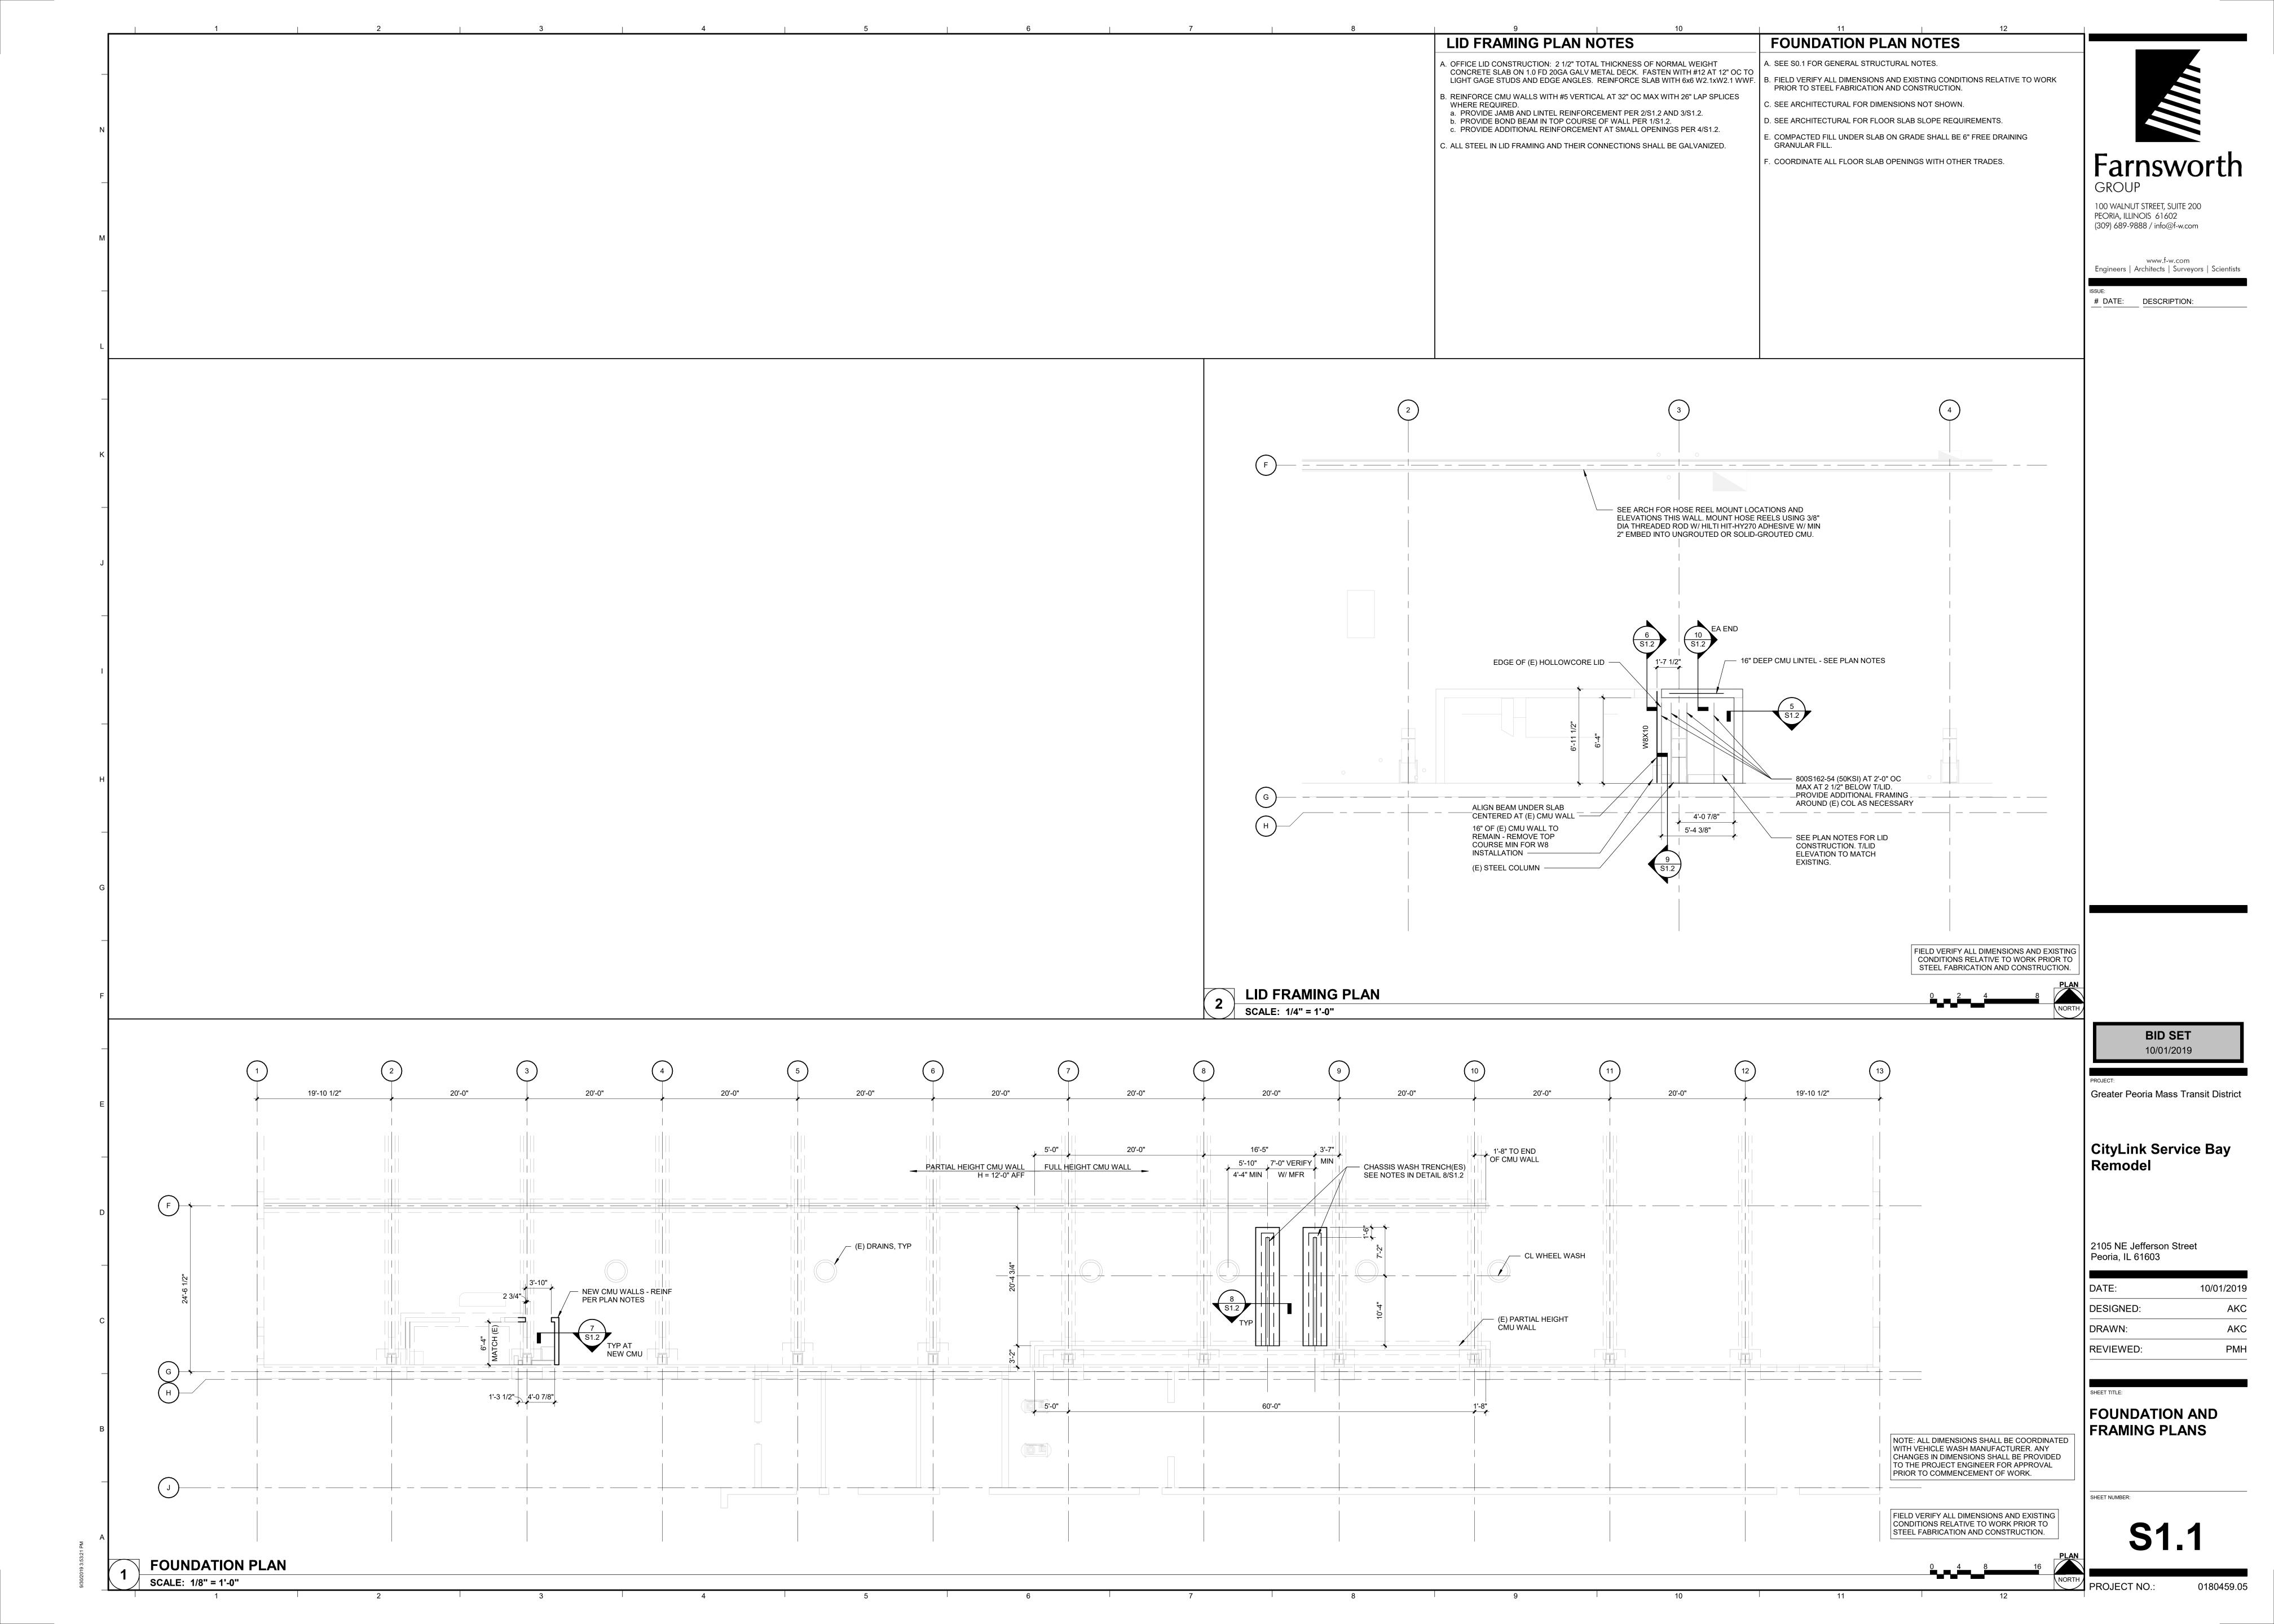


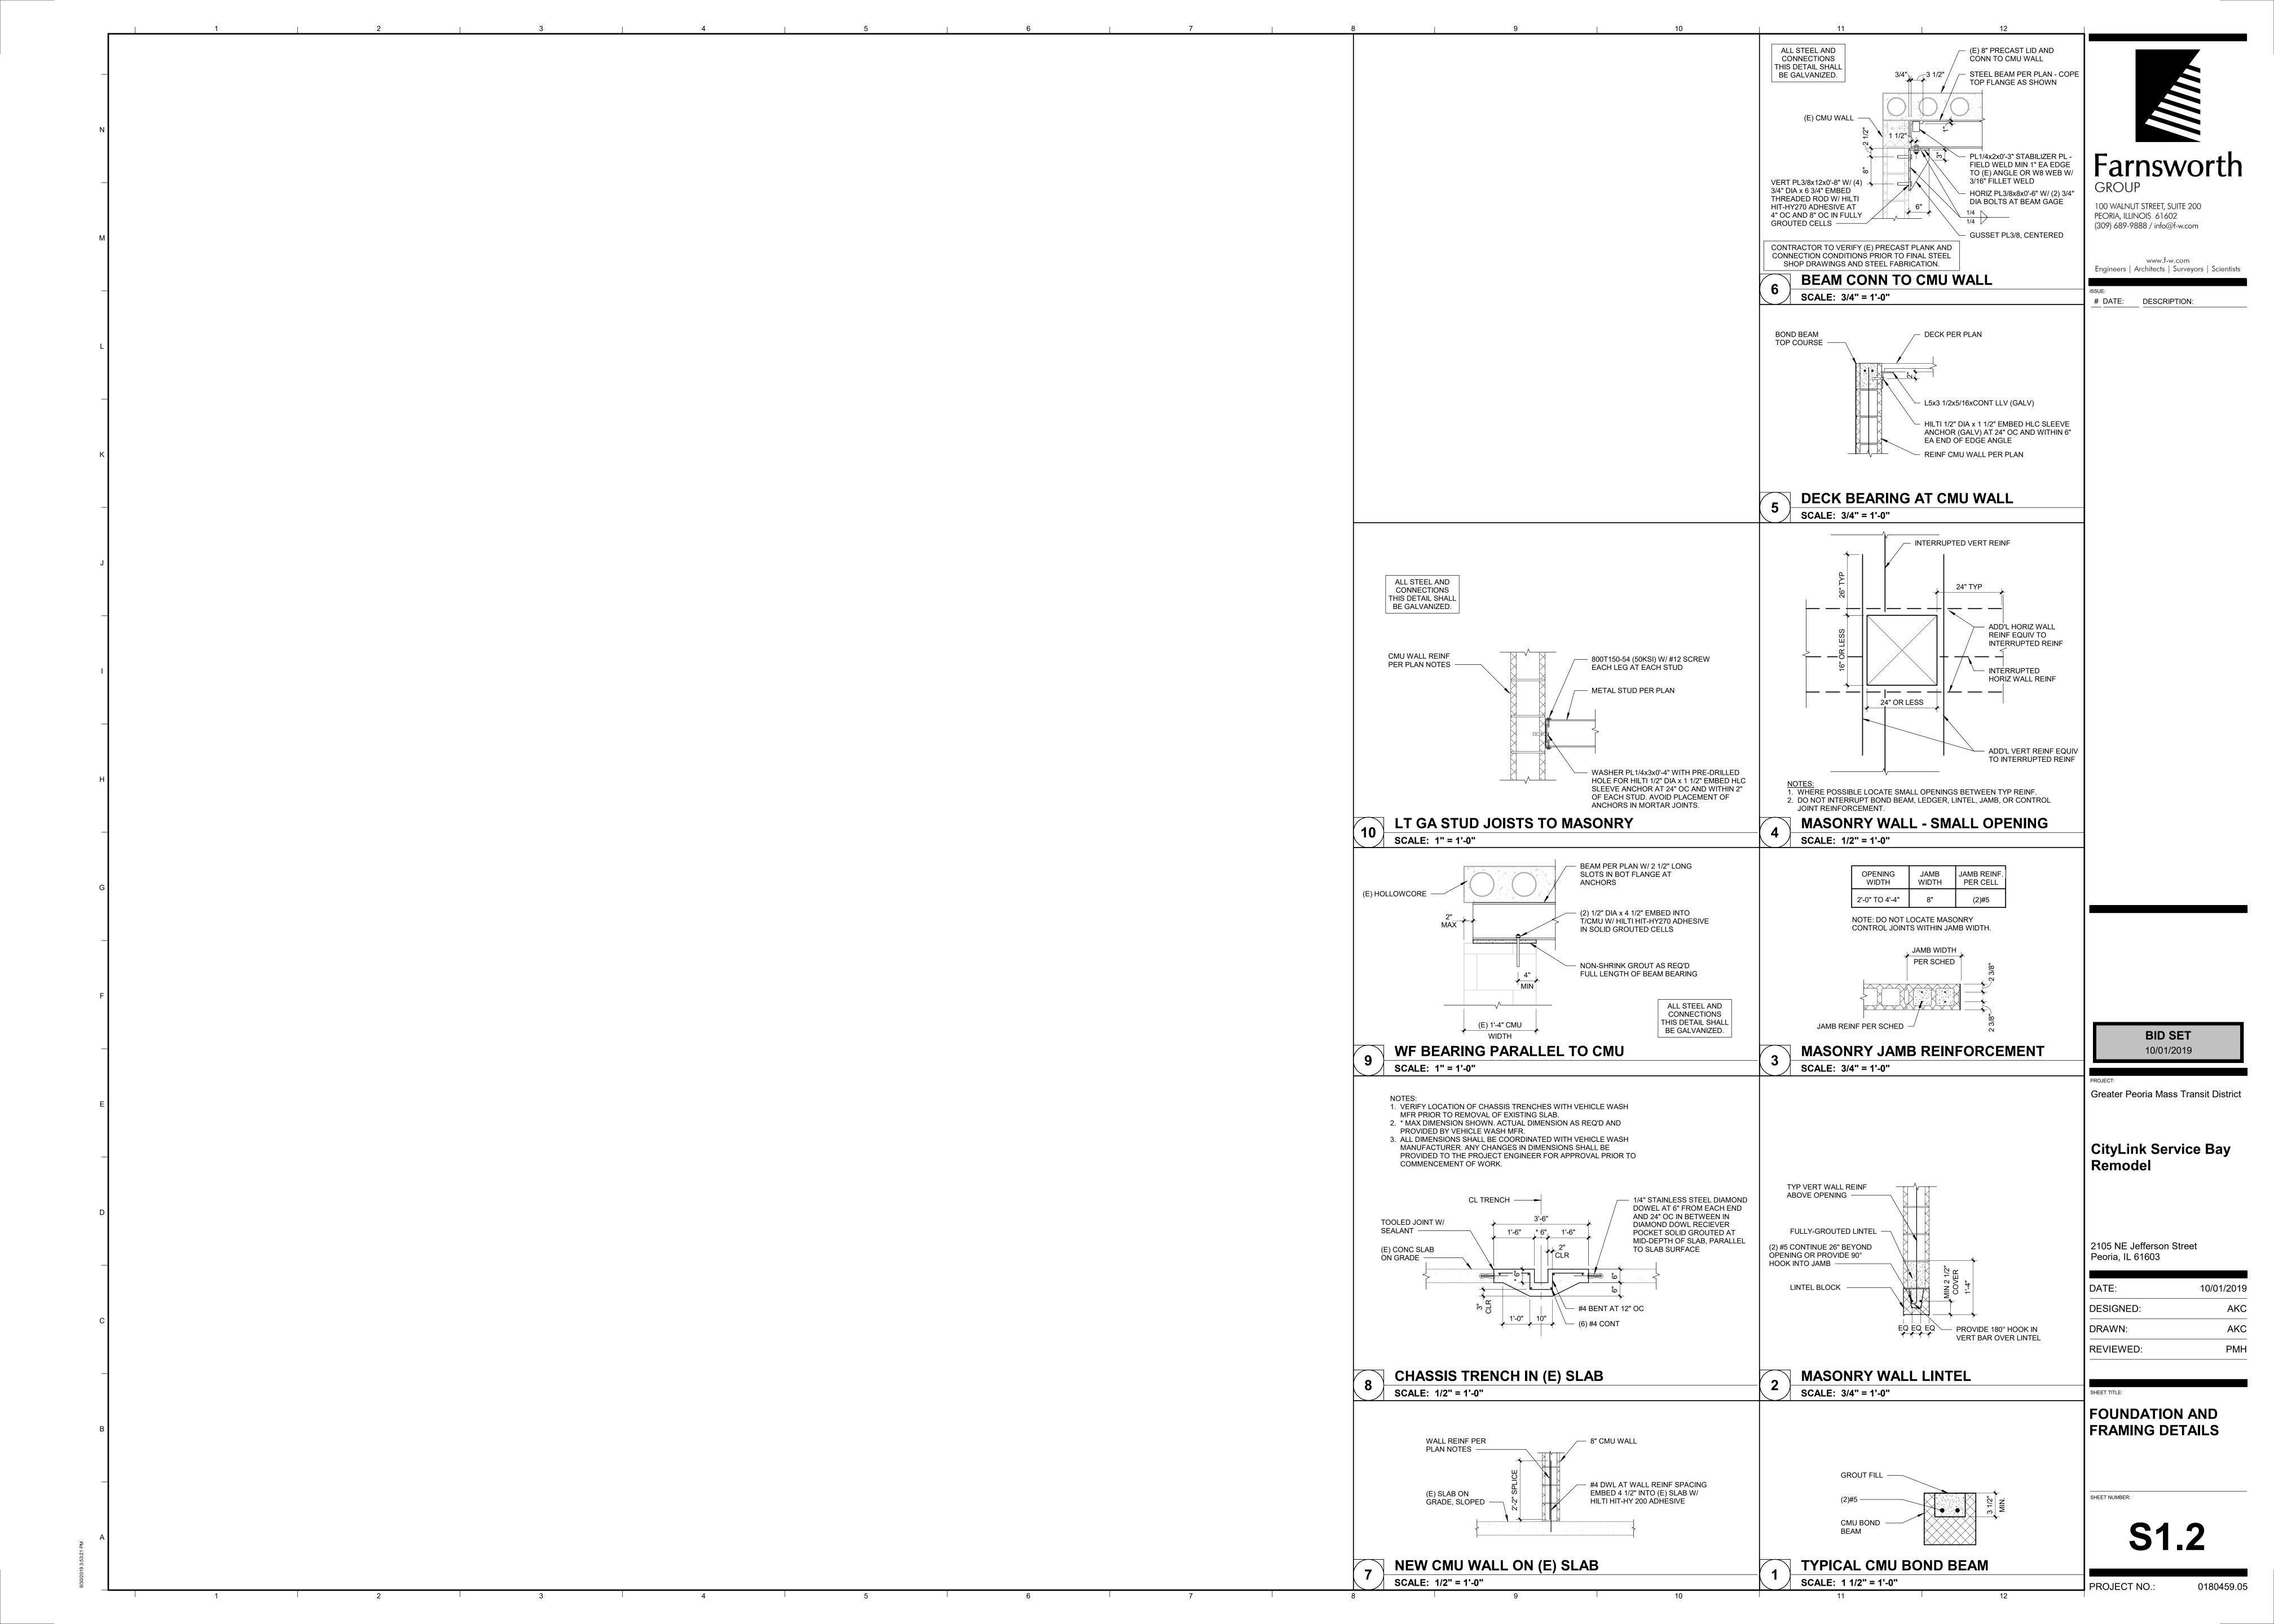

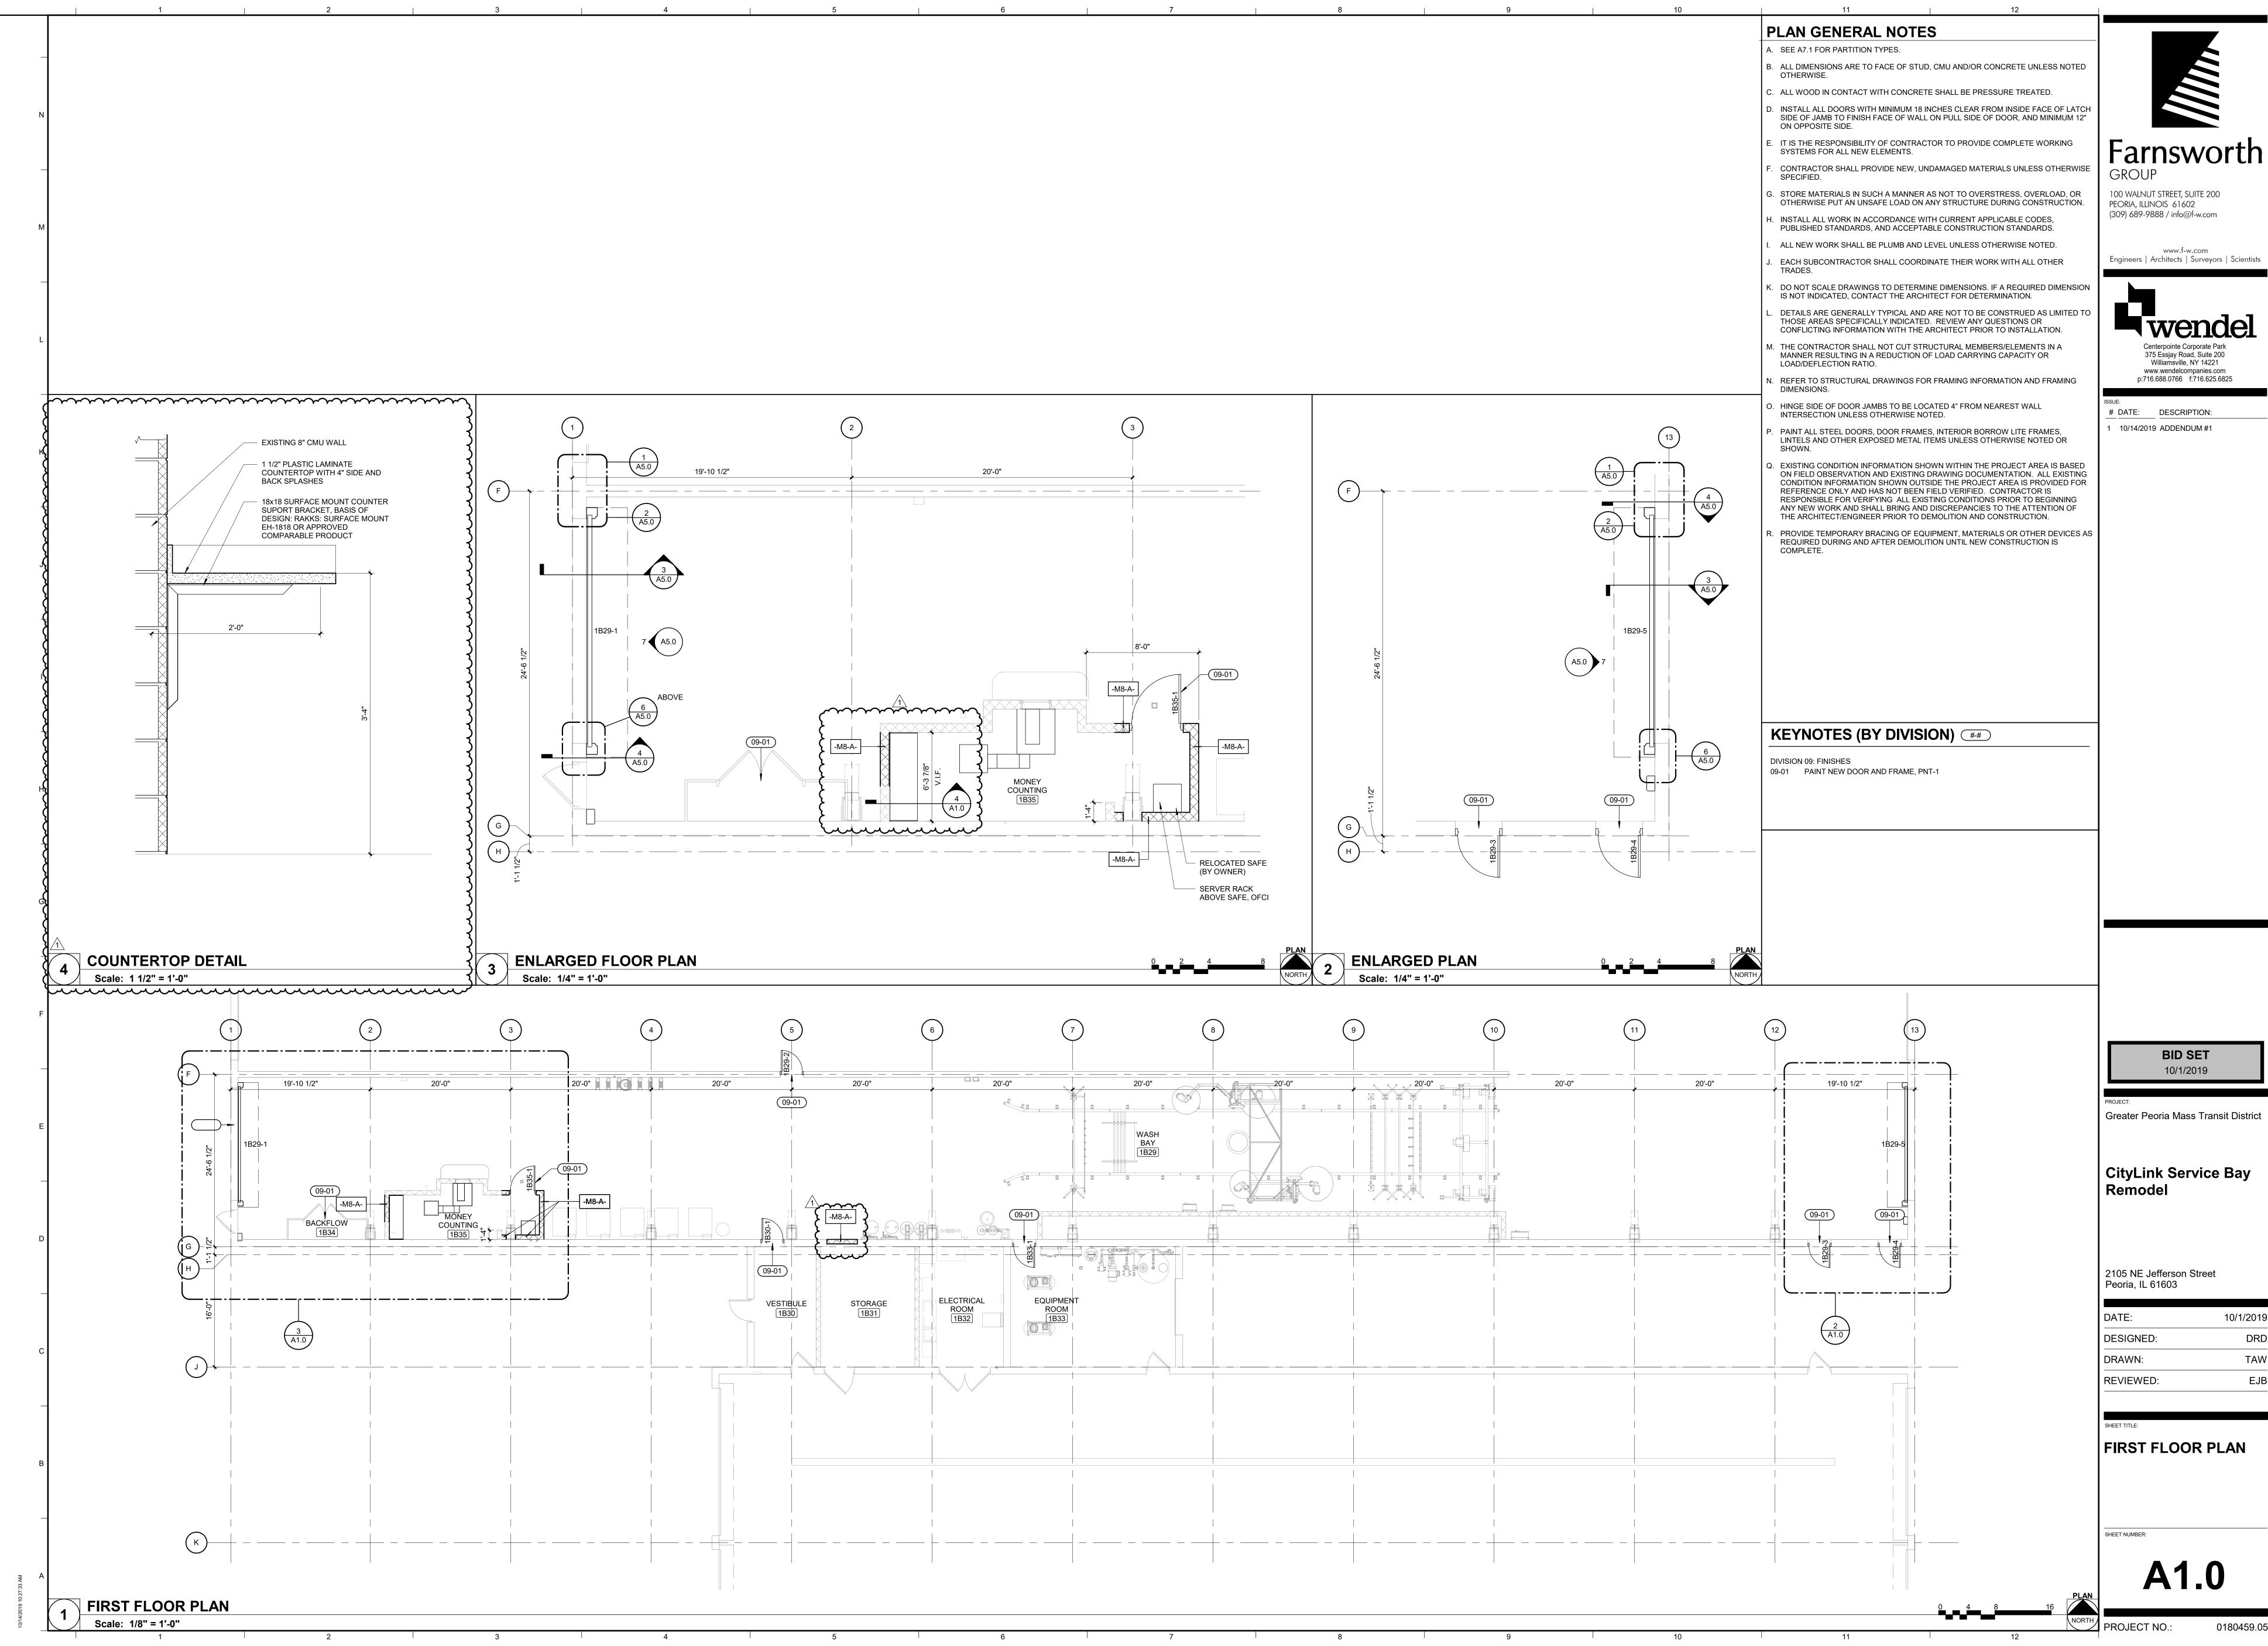



DATE:	10/1/2019
DESIGNED:	DRD
DRAWN:	TAW
REVIEWED:	EJB

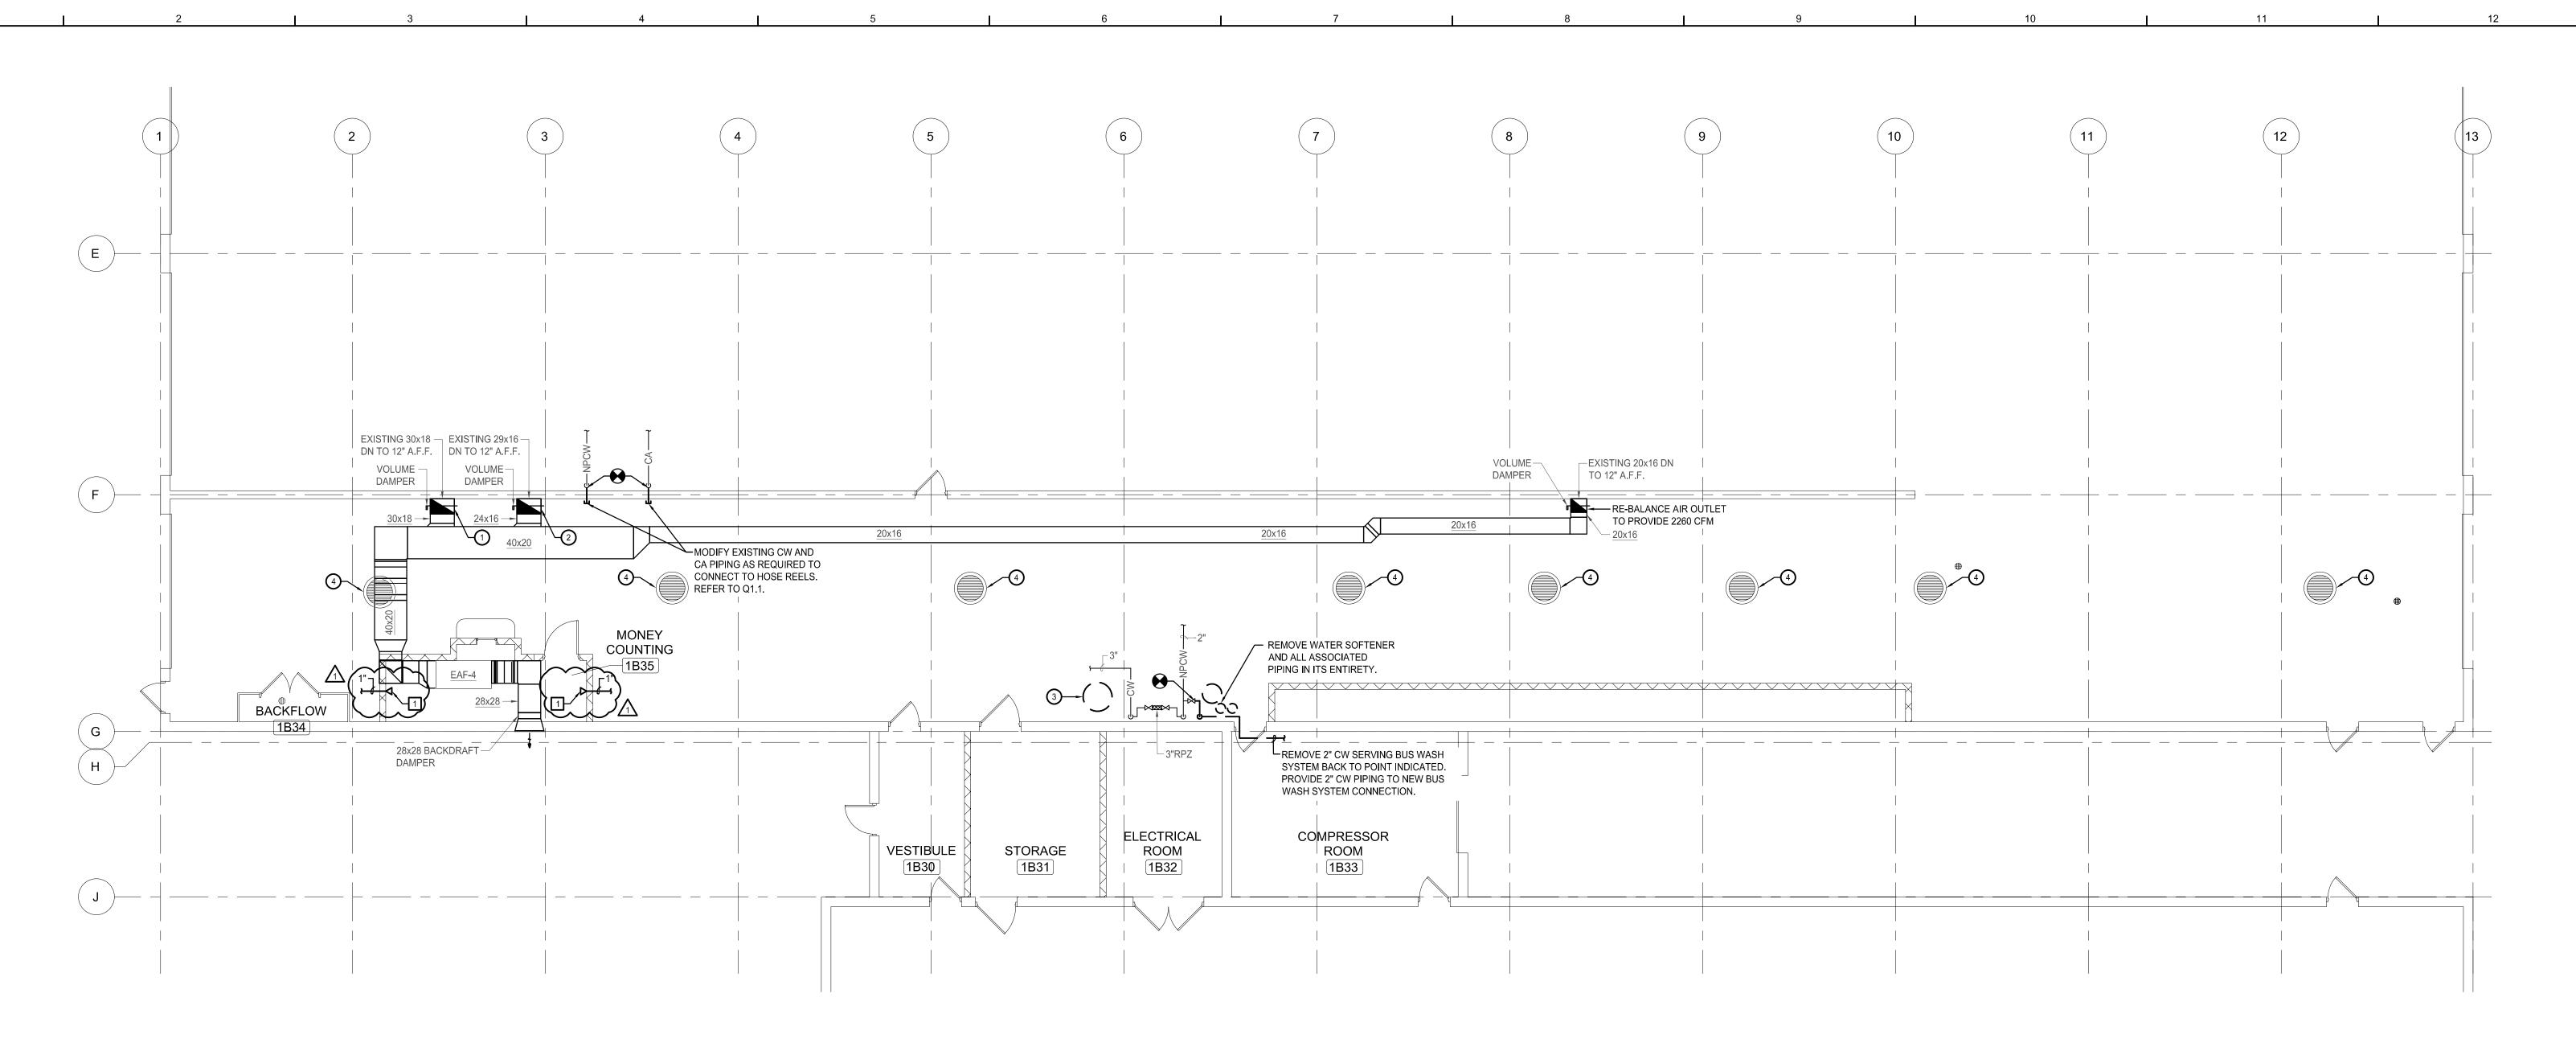

1 FIRST FLOOR MECHANICAL PLAN SCALE: 1/8" = 1'-0"

**EXISTING** 

**EXPANSION TANK** 

FLOOR CLEANOUT

FROM FLOOR ABOVE

FROM FLOOR BELOW

FLUID LUBRICATION

GENERAL CONTRACTOR GALLONS PER HOUR

GAS WATER HEATER

FLOOR DRAIN

FAHRENHEIT DEGREES

FURNISHED BY OTHERS

EMERGENCY STORM SEWER

CEB

CFH

CO

CW

CKV

DN

DSN

DTF

DWH

EST

EXIST.

## **ABBREVIATIONS**

<del> </del>		<del></del>	
ABOVE FINISHED FLOOR	НВ	HOSE BIBB	
ABOVE GRADE	HC	HVAC CONTRACTOR	
AIR COMPRESSOR	HW	HOT WATER	
BALANCING VALVE	HP	HORSEPOWER	
BELOW FINISHED FLOOR BACKFLOW PREVENTER BALL VALVE	M MV	METER MIXING VALVE	
COMPRESSED AIR	NIC	NOT IN CONTRACT	
CATCH BASIN	NTS	NOT TO SCALE	
CONCRETE EQUIPMENT BASE			
CUBIC FEET PER HOUR	OI	OIL INTERCEPTOR	
CAST IRON			
CLEANOUT	_	55	
COLD WATER	P	PUMP	
COMMON VENT	PCAC PC	PIPE CONNECTION AT CEILING PLUMBING CONTRACTOR	
CHECK VALVE			
	PET PEN	PLUMBING EXPANSION TANK	
DOWNSPOUT	PRV	PRESSURE REDUCING VALVE	
DOWN THRU FLOOR	55	DOOF DDAW	
DOWN DUCTILE IRON	RD RWL	ROOF DRAIN RAIN WATER LEADER	
DOWN SPOUT NOZZLE	KVVL	RAIN WATER LEADER	
DOWN THROUGH FLOOR	0.444	OANUTA DV OEINED	
DOMESTIC WATER HEATER	SAN	SANITARY SEWER	
	SF	SQUARE FOOT	
ELECTRICAL CONTRACTOR	ST	STORM SEWER	
EQUIPMENT EMERGENCY STORM SEWER	STR	STRAINER	

VENT

VENT THROUGH ROOF

WATER HAMMER ARRESTOR

WALL CLEANOUT

WATER GAUGE

WALL HYDRANT

WATER METER

WASTE STACK VENT

# SYMBOLS - VALVES AND SPECIALTIES

TIVIDOLO VALVEO	AND OI LOIALTIL
$\bowtie$	SHUT-OFF VALVE (GATE, BALL, ETC.)
$\bigcirc$	SHUT-OFF VALVE IN RISER
	CHECK VALVE
Ŋ	STRAINER
	BRANCH CONNECTION - BOTTOM
	BRANCH CONNECTION - TOP
	ELBOW - TURNED DOWN
<del></del>	ELBOW - TURNED UP
	CAP
—— FCO WCO	CLEANOUT (FLOOR/WALL)
——— <b>⊙©</b>	FLOOR DRAIN
—— <del> </del> ⊢ WH	WALL HYDRANT
——— НВ	HOSE BIBB
——————————————————————————————————————	UNION
	DIRECTION OF FLOW
lacktriangle	POINT OF CONNECTION / REMOVAL

# SYMBOLS - PIPING DESIGNATIONS

cw	COLD WATER
NPCW	NON POTABLE COLD WATER
CA	COMPRESSED AIR

## **DEMOLITION NOTES:**

- 1. REMOVE 30x18 DUCT FROM FLOOR BACK TO FLANGED JOINT AT APPROXIMATELY 10' ABOVE FINISHED FLOOR. MAINTAIN VOLUME DAMPER IN SECTION OF DUCT ABOVE. PROVIDE NOMINAL 28"x16" PRICE MODEL 520D SUPPLY REGISTER (OR APPROVED EQUAL) WITH OPPOSED BLADE VOLUME DAMPER ON BOTTOM OF DUCT TO DISCHARGE AIR DOWN TOWARD FLOOR. MODIFY DUCT AS REQUIRED TO ACCOMMODATE AIR DEVICE. RE-BALANCE AIR OUTLET TO PROVIDE 3,170 CFM.
- 2. REMOVE 29x16 DUCT FROM FLOOR BACK TO FLANGED JOINT AT APPROXIMATELY 8' ABOVE FINISHED FLOOR. MAINTAIN VOLUME DAMPER IN SECTION OF DUCT ABOVE. PROVIDE NOMINAL 26"x14" PRICE MODEL 520D SUPPLY REGISTER (OR APPROVED EQUAL) WITH OPPOSED BLADE VOLUME DAMPER ON BOTTOM OF DUCT TO DISCHARGE AIR DOWN TOWARD FLOOR. MODIFY DUCT AS REQUIRED TO ACCOMMODATE AIR DEVICE. RE-BALANCE AIR OUTLET TO PROVIDE 2,570 CFM.
- 3. REMOVE DOMESTIC WATER HEATER IN ITS ENTIRETY. REMOVE HW PIPING IN ITS ENTIRETY. REMOVE CW PIPING BACK TO MAIN AND CAP. REMOVE GAS PIPING BACK TO MAIN AND CAP. REMOVE FLUE IN ITS ENTIRETY, COORDINATE WITH ROOF MANUFACTURER FOR PATCHING OF ROOF.
- 4. JET FLUSH CATCH BASINS AND ASSOCIATED DRAINAGE PIPE.

# CONSTRUCTION NOTES:

MODIFY EXISTING SPRINKLER PIPING TO MONEY COUNTING ROOM 1B35. PROVIDE SIDEWALL QUICK RESPONSE, 5.6K SPRINKLER HEADS WHERE INDICATED. PROVIDE SCHEDULE 40 THREADED BLACK STEEL PIPING, EXTEND PIPING TO NEAREST FIRE PROTECTION MAIN.

## GENERAL NOTES:

- 1. THIS LEGEND SHEET IS FOR THE CONTRACTORS REFERENCE ONLY. NOT ALL SYMBOLS AND/OR ABBREVIATIONS MAY APPLY TO THIS PARTICULAR PROJECT. ANY ADDITIONS OR OMISSIONS FROM THIS LEGEND SHEET DOES NOT IMPLY INCLUSION AND/OR EXCLUSION OF ANY PARTICULAR ITEM FROM THE PROJECT.
- 2. THE PLANS ARE DIAGRAMMATIC AND INDICATE ONLY THE SIZE AND GENERAL ARRANGEMENT OF PIPING AND EQUIPMENT. EXACT LOCATION OF ALL ELEMENTS SHALL BE DETERMINED AS WORK PROGRESSES, IN COOPERATION AND COORDINATION WITH THE WORK OF ALL OTHER TRADES. IT IS NOT INTENDED TO SHOW EVERY ITEM OF WORK OR MINOR PIECE OF EQUIPMENT, BUT THE CONTRACTOR SHALL FURNISH AND INSTALL WITHOUT ADDITIONAL REMUNERATION ANY COMPONENT NECESSARY TO COMPLETE THE SYSTEM IN ACCORDANCE WITH THE BEST PRACTICE OF THE TRADE.
- 3. ITEMS OF WORK OR EQUIPMENT SHOWN ON THE DRAWINGS ONLY, OR CALLED FOR IN THE SPECIFICATIONS ONLY, SHALL BE FURNISHED AND INSTALLED IN THE SAME MANNER AS IF THEY APPEARED ON BOTH THE DRAWINGS AND SPECIFICATIONS.
- 4. DRAWINGS DO NOT INDICATE ALL OFFSETS, CHANGES IN ELEVATIONS, ETC. WHICH MAY BE REQUIRED. THE CONTRACTOR SHALL MAKE SUCH CHANGES IN PIPING AND LOCATION OF EQUIPMENT, ETC. TO ACCOMMODATE WORK WITH THAT OF OTHER CONTRACTORS.
- 5. INSTALL EQUIPMENT AND PIPING TO AVOID INTERFERENCE WITH THE OPERATION OR SERVICING AND MAINTENANCE OF EQUIPMENT.
- 6. PIPES PENETRATING FIRE WALLS AND FLOORS SHALL BE FIRESTOPPED AS SPECIFIED. REFER TO THE ARCHITECTURAL DRAWINGS FOR FIRE WALL AND FLOOR LOCATIONS.
- 7. ALL PHYSICAL ATTRIBUTES OF EQUIPMENT AND DEVICES ARE BASED ON THOSE MANUFACTURERS LISTED IN THE SPECIFICATIONS AND/OR THE EQUIPMENT SCHEDULES. THE RESPECTIVE CONTRACTORS ARE RESPONSIBLE FOR ALL CHANGES BROUGHT ABOUT BY USE OF ITEMS BY OTHER MANUFACTURERS. THE ARCHITECT/ENGINEER HAS RESERVED THE RIGHT TO REJECT ITEMS BY OTHER MANUFACTURERS IF THOSE ITEMS DO NOT MATCH THE PHYSICAL ATTRIBUTES OF THE MANUFACTURERS LISTED.
- 8. COMPLY WITH THE ILLINOIS STATE BUILDING CODE, ILLINOIS STATE PLUMBING CODE, ILLINOIS STATE ENERGY CONSERVATION CODE, NFPA, ASHRAE 90.1 AND OTHER APPLICABLE CODES.

PLUMBING PIPE SCHEDULE												
SERVICE	SIZE	MATERIAL	PIPE	JOINTS	FITTINGS							
SERVICE	SIZE	IVIATERIAL	WEIGHT	JOINTS	MATERIAL	CLASS						
COLD WATER ABOVE GROUND	2"AND DN	TYPE L COPPER	-	SOLDER	WROUGHT COPPER	-						
COMPRESSED AIR	2" AND DN	CARBON STEEL, A53 GR. B ERW	SCHEDULE 40	THREADED	MALLEABLE IRON	150						



PEORIA, ILLINOIS 61602 (309) 689-9888 / info@f-w.com

www.f-w.com Engineers | Architects | Surveyors | Scientists



# DATE: DESCRIPTION: 10/11/19 ADDENDUM#1

> **BID SET** 10/01/2019

Greater Peoria Mass Transit District

CityLink Service Bay Remodel


2105 NE Jefferson Street Peoria, IL 61603


DATE:	10/01/2019
DESIGNED:	KGP
DRAWN:	KGP
REVIEWED:	CRL

FIRST FLOOR

MECHANICAL PLAN

PROJECT NO.:

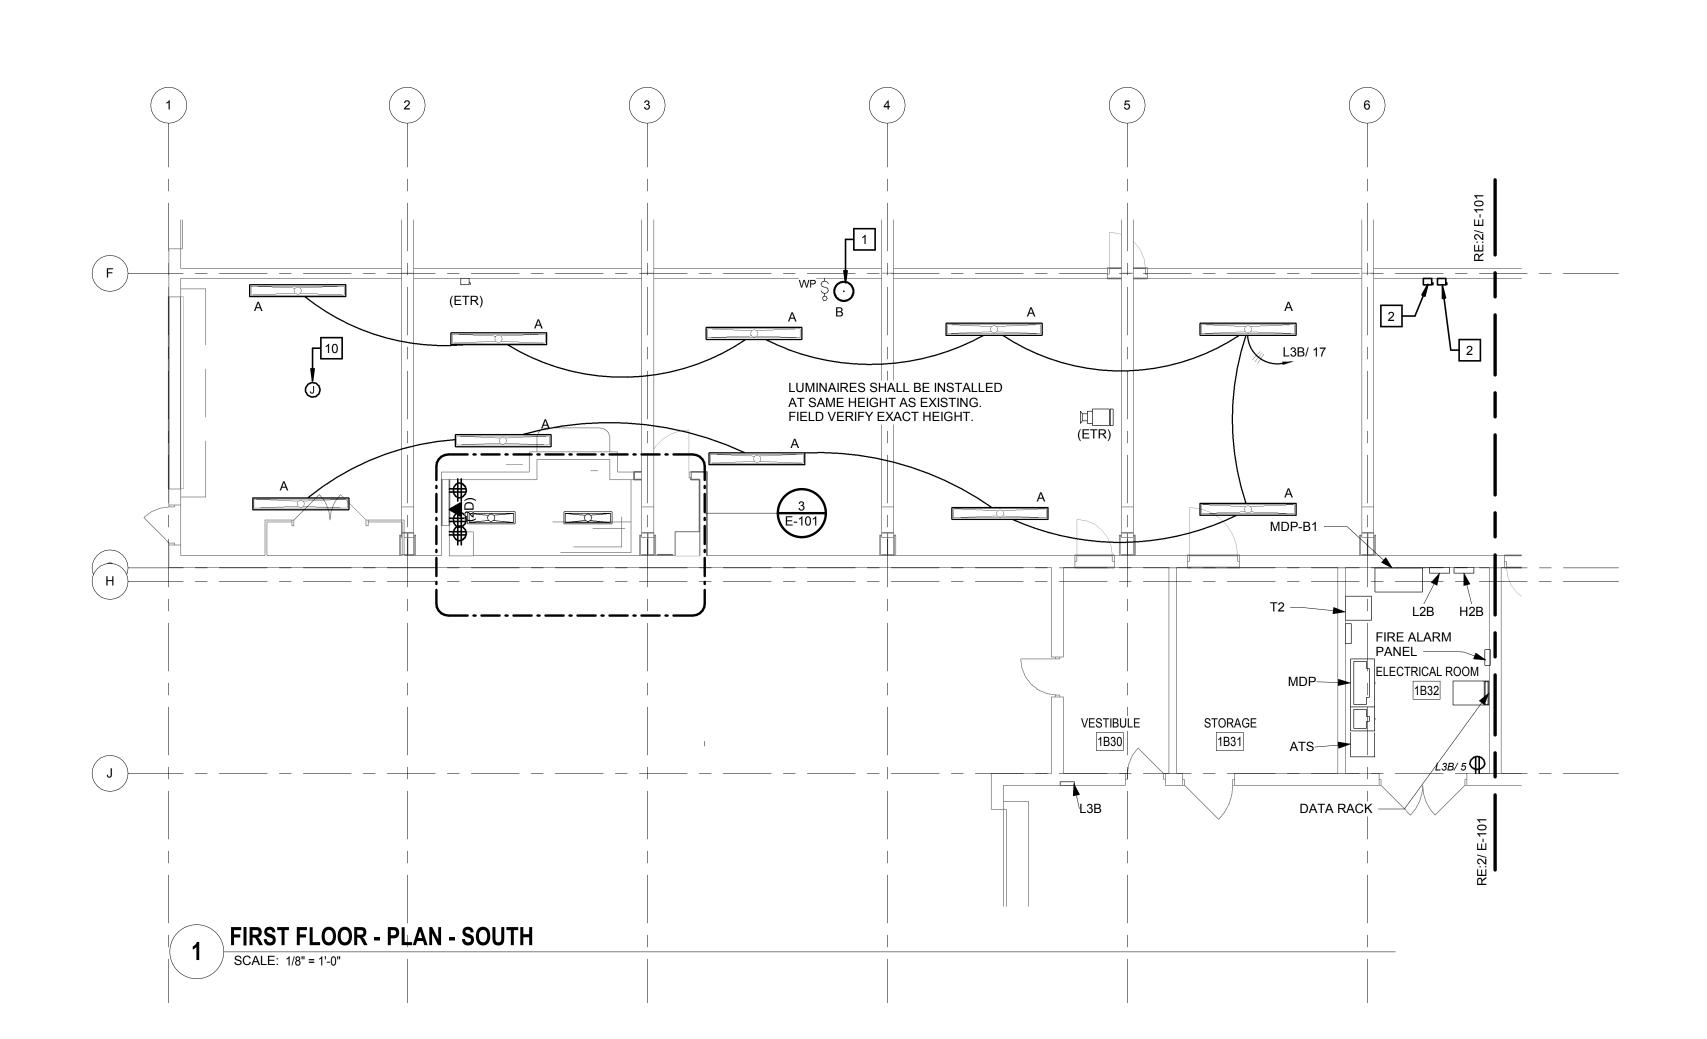

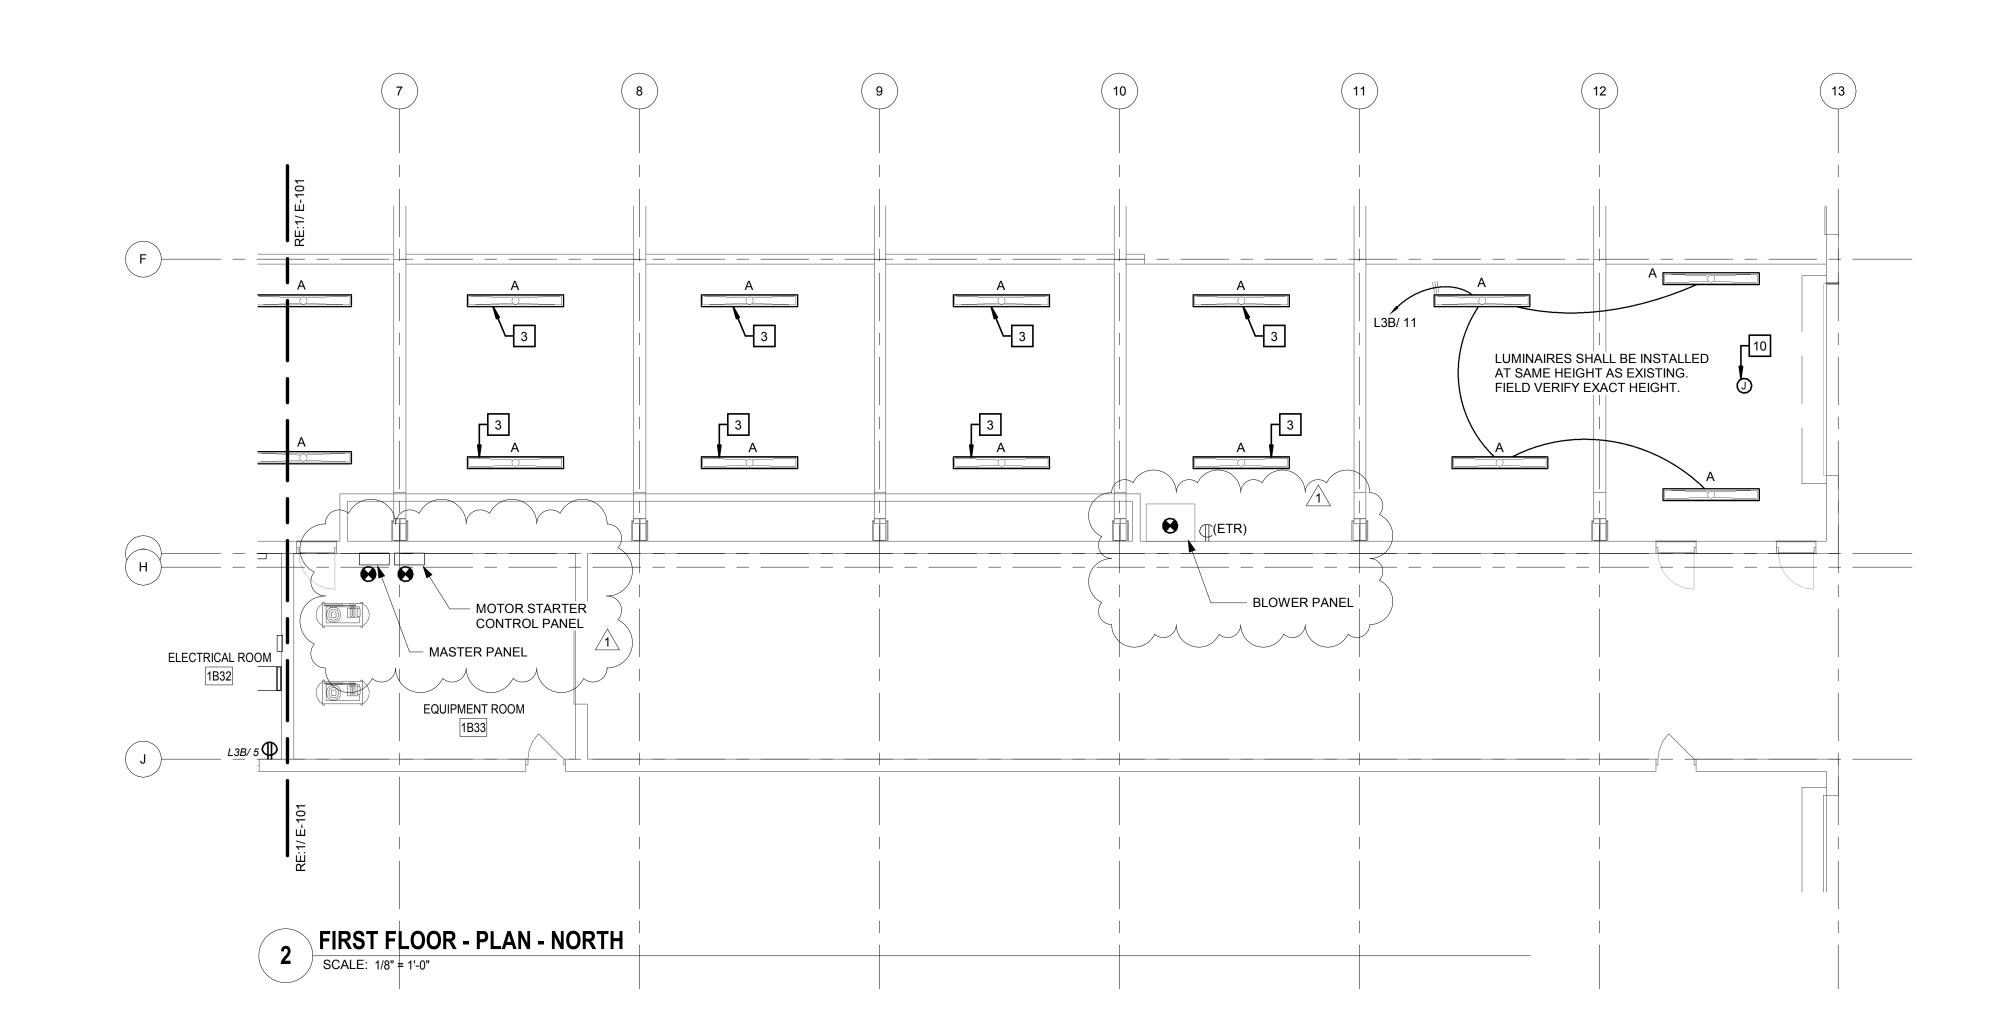

### **GENERAL NOTES:**


- A. THE USE OF MC CABLE IS PROHIBITED IN THE BUS WASH SERVICE LANE OR MONEY ROOM. USE OF MC CABLE MUST BE APPROVED BY ENGINEER.
- B. CONTRACTOR SHALL BE RESPONSIBLE FOR ALL INTERCONNECTING OF BUS WAS EQUIPMENT. CONTRACTOR SHALL REFER TO DRAWING LY19-074-06A AND LY19-074-06B FOR ALL ADDITIONAL REQUIREMENTS.

### **#CONSTRUCTION NOTES:**

- 1. UTILIZE EXISTING BRANCH CIRCUIT FOR NEW LIGHTING FIXTURE AND WEATHER PROOF SWITCH. PROVIDE 2 #12 & #12EG IN 3/4" CONDUIT.
- 2. PROVIDE NEMA 4 STAINLESS STEEL 30 AMP 3 PHASE 4 WIRE STARTER DISCONNECT AND RECONNECT LINE AND LOAD FEEDERS. EXTEND FEEDERS AS REQUIRED. PROVIDE 3#10 & #10EG IN 1' CONDUIT.
- 3. UTILIZE EXISTING BRANCH CIRCUIT FOR NEW LIGHTING FIXTURE. EXTEND EXISTING BRANCH CIRCUIT AS REQUIRED PROVIDE 2#12 & #12EG IN 3/4" CONDUIT
- 4. RELOCATED LIGHTING SWITCH CONTROL FOR MONEY ROOM. PROVIDE 2#12 & #12EG IN 3/4" CONDUIT.
- 5. RELOCATED DOOR CONTRACTOR FOR SECURITY SYSTEM. EXTEDN SYSTEM WIRING AS REQUIRED AND

PROVIDE 1/2" CONDUIT OR CONCEAL CABLE IN

- 6. PROVIDE 3' x 3' x 3' WALL MOUNTED DATA RACK WITH FRONT REMOVABLE LEXAN HINGED DOOR FOR MOUNTING MONEY ROOM SERVER AND COMPUTER.
- 7. RELOCATED DUPLEX RECEPTACLES FOR POWERING WALL MOUNTED DATA RACK.
- 8. PROVIDE JUNCTION BOX AND 1" CONDUIT BACK TO DATA RACK IN ELECTRIC ROOM FOR NEW OWNER SUPPLIED CAMERA. PROVIDE CATEGORY 6 CABLE AND TERMINATE AT DATA RACK AND PROVIDE WITH RJ45 JACK AT JUNCTION BOX.
- 9. PROVIDE 2'x2'x4' PLYWOOD BACKER BOARD FOR MOUNTING MONEY MACHINE CONTROL PANELS. MOUNT RELOCATED CONTROL PANELS AND PROVIDE NEW CABLE FROM JUNCTION BOX AND MONEY MACHINE TO PANELS IN 3/4" CONDUIT. CABLE SHALL BE ALPHA WIRE-NR 9852C 3PR22AWG, 1PR20AWG SHIELDED OR SIMILAR.
- 10. UTILIZE EXISTING BRANCH CIRCIT FOR CONNECITON TO \_NEW OVERHEAD DOOR MOTOR AND OPERATOR. PROVIDE 2#12+#12EG IN 3/4" CONDUIT AS REQUIRED.
- 11. PROVIDE 2 CATEGORY 6 DATA CABLES BACK TO DATA RACK IN ROOM 1B32 AND TERMINATE ON EXISITNG PATCH PANEL. PROVIDE FOUR (4) 3' CATEGORY G PATCH PANELS FOR TYING INTO NETWORK.

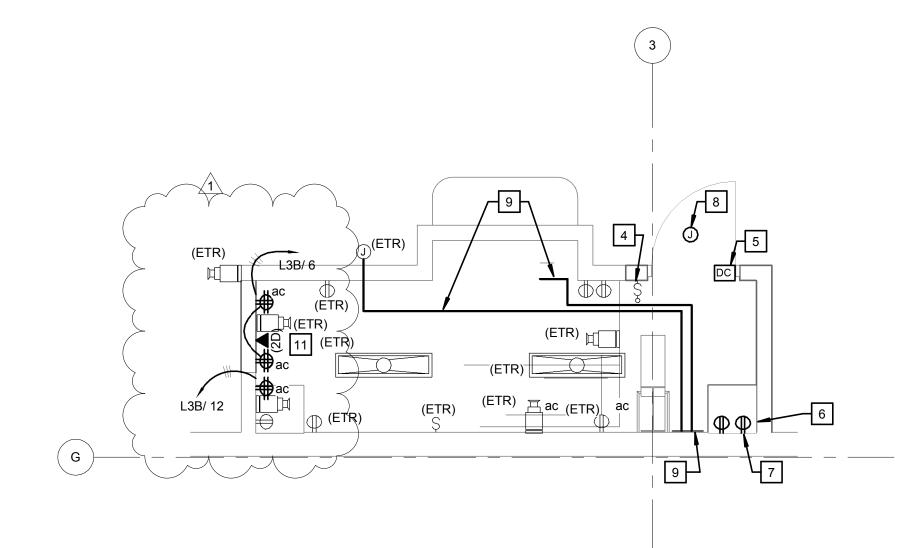

3 ENLARGED PLAN - MONEY ROOM
SCALE: 1/4" = 1'-0"

Farnsworth GROUP

100 WALNUT STREET, SUITE 200 PEORIA, ILLINOIS 61602 (309) 689-9888 / info@f-w.com

www.f-w.com Engineers | Architects | Surveyors | Scientists



# DATE: DESCRIPTION:

WENDEL ENGINEERING P.C.

10/11/19 ADDENDUM #1

**BID SET** 

Greater Peoria Mass Transti District

CityLink Service Bay Remodel


2105 NE Jefferson Street Peoria, IL 61603

DATE:	08/09/2019
DESIGNED:	CDW
DRAWN:	MLH
REVIEWED:	JJR

FIRST FLOOR PLAN

# CONSTRUCTION NOTES:

1. PROVIDE NOTED BREAKER IN EXISITING PANEL MATCHING EXISTING TYPE AND A.I.C RATING.

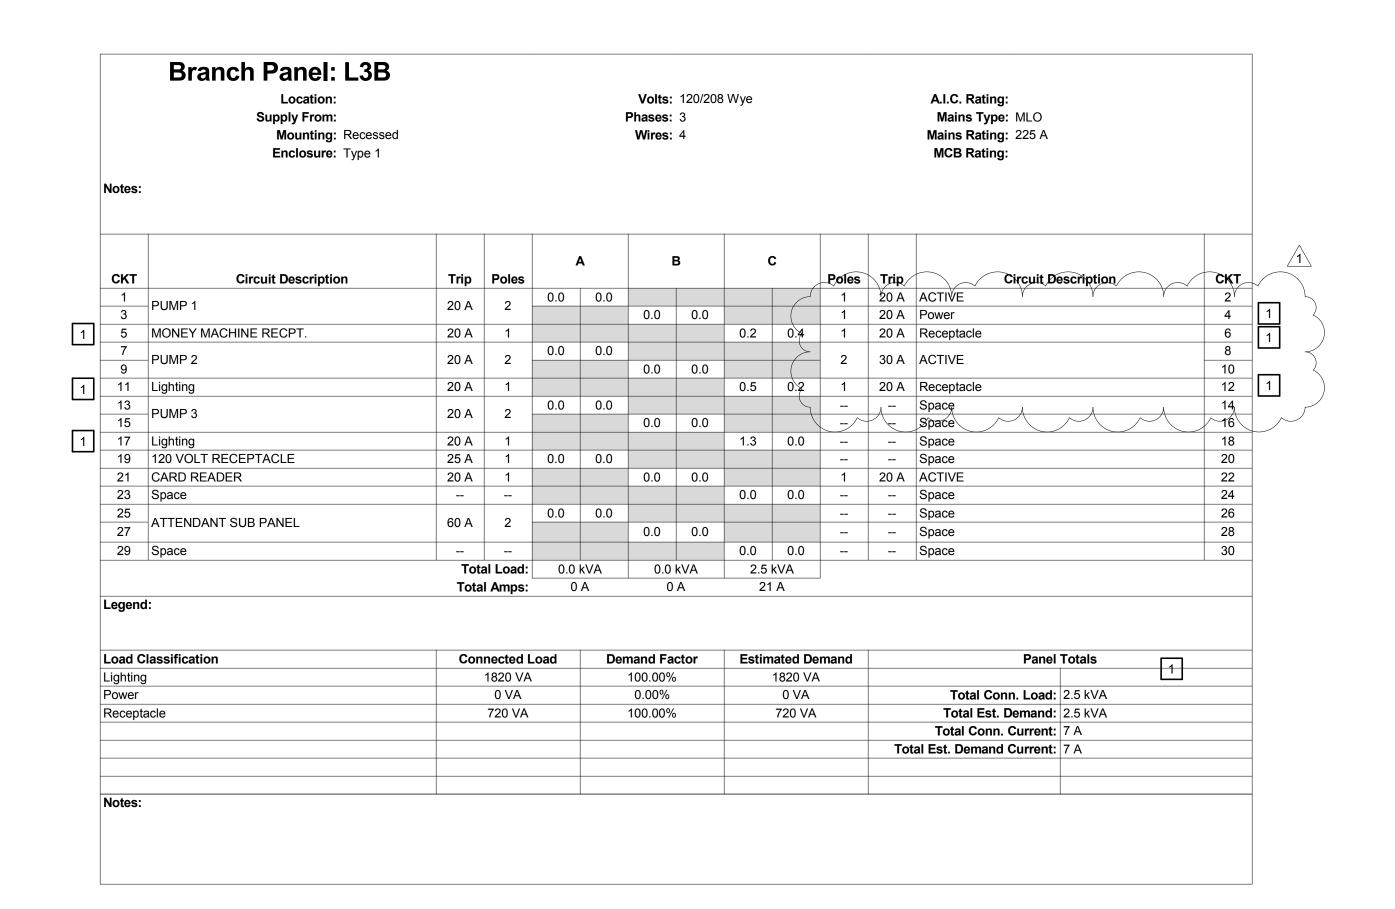

	Location: ELECTRICAL ROOM 1B32 Supply From: Mounting: Surface Enclosure: Type 1			Volts: 480/277 Wye Phases: 3 Wires: 4							A.I.C. Rating: Mains Type: Mains Rating: 600 A MCB Rating:					
Notes:																
СКТ	Circuit Description	Trip	Poles		A		В		С	Poles	Trip	Circuit De	escription	CH		
1	Official Description	11119	1 0103	0.0	0.0					1 0103	ШР	Oli Call De	Somption	2		
3	MAU-1	600 A	3	0.0	0.0	0.0	0.0			3	30 A	PRE 2 & 3		4		
5							1.0	0.0	0.0	1				6		
7				0.0	0.0			1.0	1.0					8		
9	MAU-2	20 A	3			0.0	0.0			3	20 A	PRE 6 & 7		1		
11								0.0	0.0					1		
13				0.0	0.0					1	20 A	ACTIVE		1		
15	MAU-3	20 A	3			0.0	0.0			1	20 A	UNIT HEATER, STORAG	SE ROOM	1		
17	1							0.0	0.0	1	20 A	ACTIVE		1		
19				0.0	0.0									2		
21	ACTIVE	20 A	3			0.0	0.0			3	30 A	BUS WASH SLAVE PAN	EL 1	2		
23								0.0	0.0					2		
25				0.0	0.0									2		
27	BUS WASH MAIN PANEL FEED	125 A	3			0.0	0.0			3	30 A	BUS WASH SLAVE PAN	NEL 2			
29								0.0	0.0					3		
		Tot	al Load:	0.0	kVA	0.0	kVA	0.0	kVA							
		Tota	al Amps:	C	Α	0	Α	0	Α	_						
Legend Load C	lassification	Con	nected L	oad.	Der	mand Fa	ctor	Estin	nated De	emand		Panel	Totals			
												Total Conn. Load:	0.0 k)/V			
												Total Est. Demand:				
												Total Conn. Current:				
											Tof	al Est. Demand Current:				
Notes:																

	LUMINAIRE SCHEDULE											
TYPE	DESCRIPTION	DRIVER	LAMPS	VOLTAGE	DESIGN MAKE	ACCEPTABLE MANUFACTURER						
A	LED SEALED INDUSTRIAL V2 SPECIALIZED WET LOCATION, IP RATED. NON-CORROSIVE LUMINAIRE, WITH WATERPROOF FITTINGS PROVIDED BY MANUFACTURER.	0-10V DIMMABLE TO 10%	4000K	UNIVERSAL VOLTAGE. 120-277 VOLT	DAY-BRITE V2WPB70L840-8-UNV-MD360W							
В	RUGGED LED LOADING DOCK LIGHTING FIXTURE WITH HIGH PERFORMANCE PHILIPS LUMILED LED CHIPS. RATED FOR OUTDOOR	LED DRIVER	4000K 23 WATT	120 VAC	TRACE LIT LDL200-4K							

EQUIPMENT CONNECTION SCHEDULE									DC	OWER SUPPLY		T					NTORL DEVICES	<b>.</b>				
		EQUIPMENT							PC	JWER SUPPLY		D	DISCONNECT SW	ITCH			NTORL DEVICES					
																12						
ITEM DESGINATION	EQUIPMENT NAME	ROOM/LOCATION	HP	kW	PHASE	VOLTAGE	SOURCE	CIRCUIT#	CIRCUIT BREAKER	CONDUCTOR, GROUND SIZE (AWG) COPPER	RACEWAY SIZE	SWITCH AMPS	FUSE SIZE	LOCATION	STARTER NEMA SIZE	COMBINATION FVNR MOTOR STARTER/DISCONNECT SW	FRACTIONAL HP DISCONNECT SWITCH	DISCONNECT SWITCH AT UNIT	PACKAGED CONTROL UNIT (SUPPLIED BY OTHERS)	THERMOSTAT CONTORL UNIT (SUPPLIED BY OTHERS)	VARIABLE FREQUENCY DRIVE (PROVIDED BY OTHERS)	NOTES
BLOWER CONTROL		SERVICE LANE	-	59.859648	3	480 V	MDP	1,3,5	90 A	4#2-#8EG	1-1/4"	-	-	-	-	-	-	-	X	-	-	
PANEL MOTOR STARTER		EQUIPMENT ROOM 1B33		E7 265406	2	490 \/	MDD	2.4.6	00.4	4#2#8EG	1 1/4"	100	00	ATIINIT								
CONTROL PANEL		EQUIPMENT ROOM 1833	-	57.365496	3	480 V	MDP	2,4,6	90 A	4#2#8EG	1-1/4"	100	90	AT UNIT	-	-	-	-	^	-	-	
MASTER PANEL		EQUIPMENT ROOM 1B33	_	0	1	120 V	L3B	4	20 A	2#12 #12EG	3/4"	_	_	-	_	_	-	X	X	_	_	

Farnsworth
GROUP

100 WALNUT STREET, SUITE 200

PEORIA, ILLINOIS 61602 (309) 689-9888 / info@f-w.com

www.f-w.com
Engineers | Architects | Surveyors | Scientists

Centerpointe Corporate Park
375 Essjay Road, Suite 200
Williamsville, NY 14221
www.wendelcompanies.com
p:716.688.0766 f:716.625.6825
WENDEL ENGINEERING P.C.

# DATE: DESCRIPTION:

1 10/11/19 ADDENDUM #1

**BID SET** 08/09/2019

Greater Peoria Mass Transti District

CityLink Service Bay Remodel

2105 NE Jefferson Street Peoria, IL 61603


DATE: 08/09/2019
DESIGNED: CDW
DRAWN: MLH
REVIEWED: JJR

SCHEDULES

SHEET NUMBER

E-500

O IECT NO :

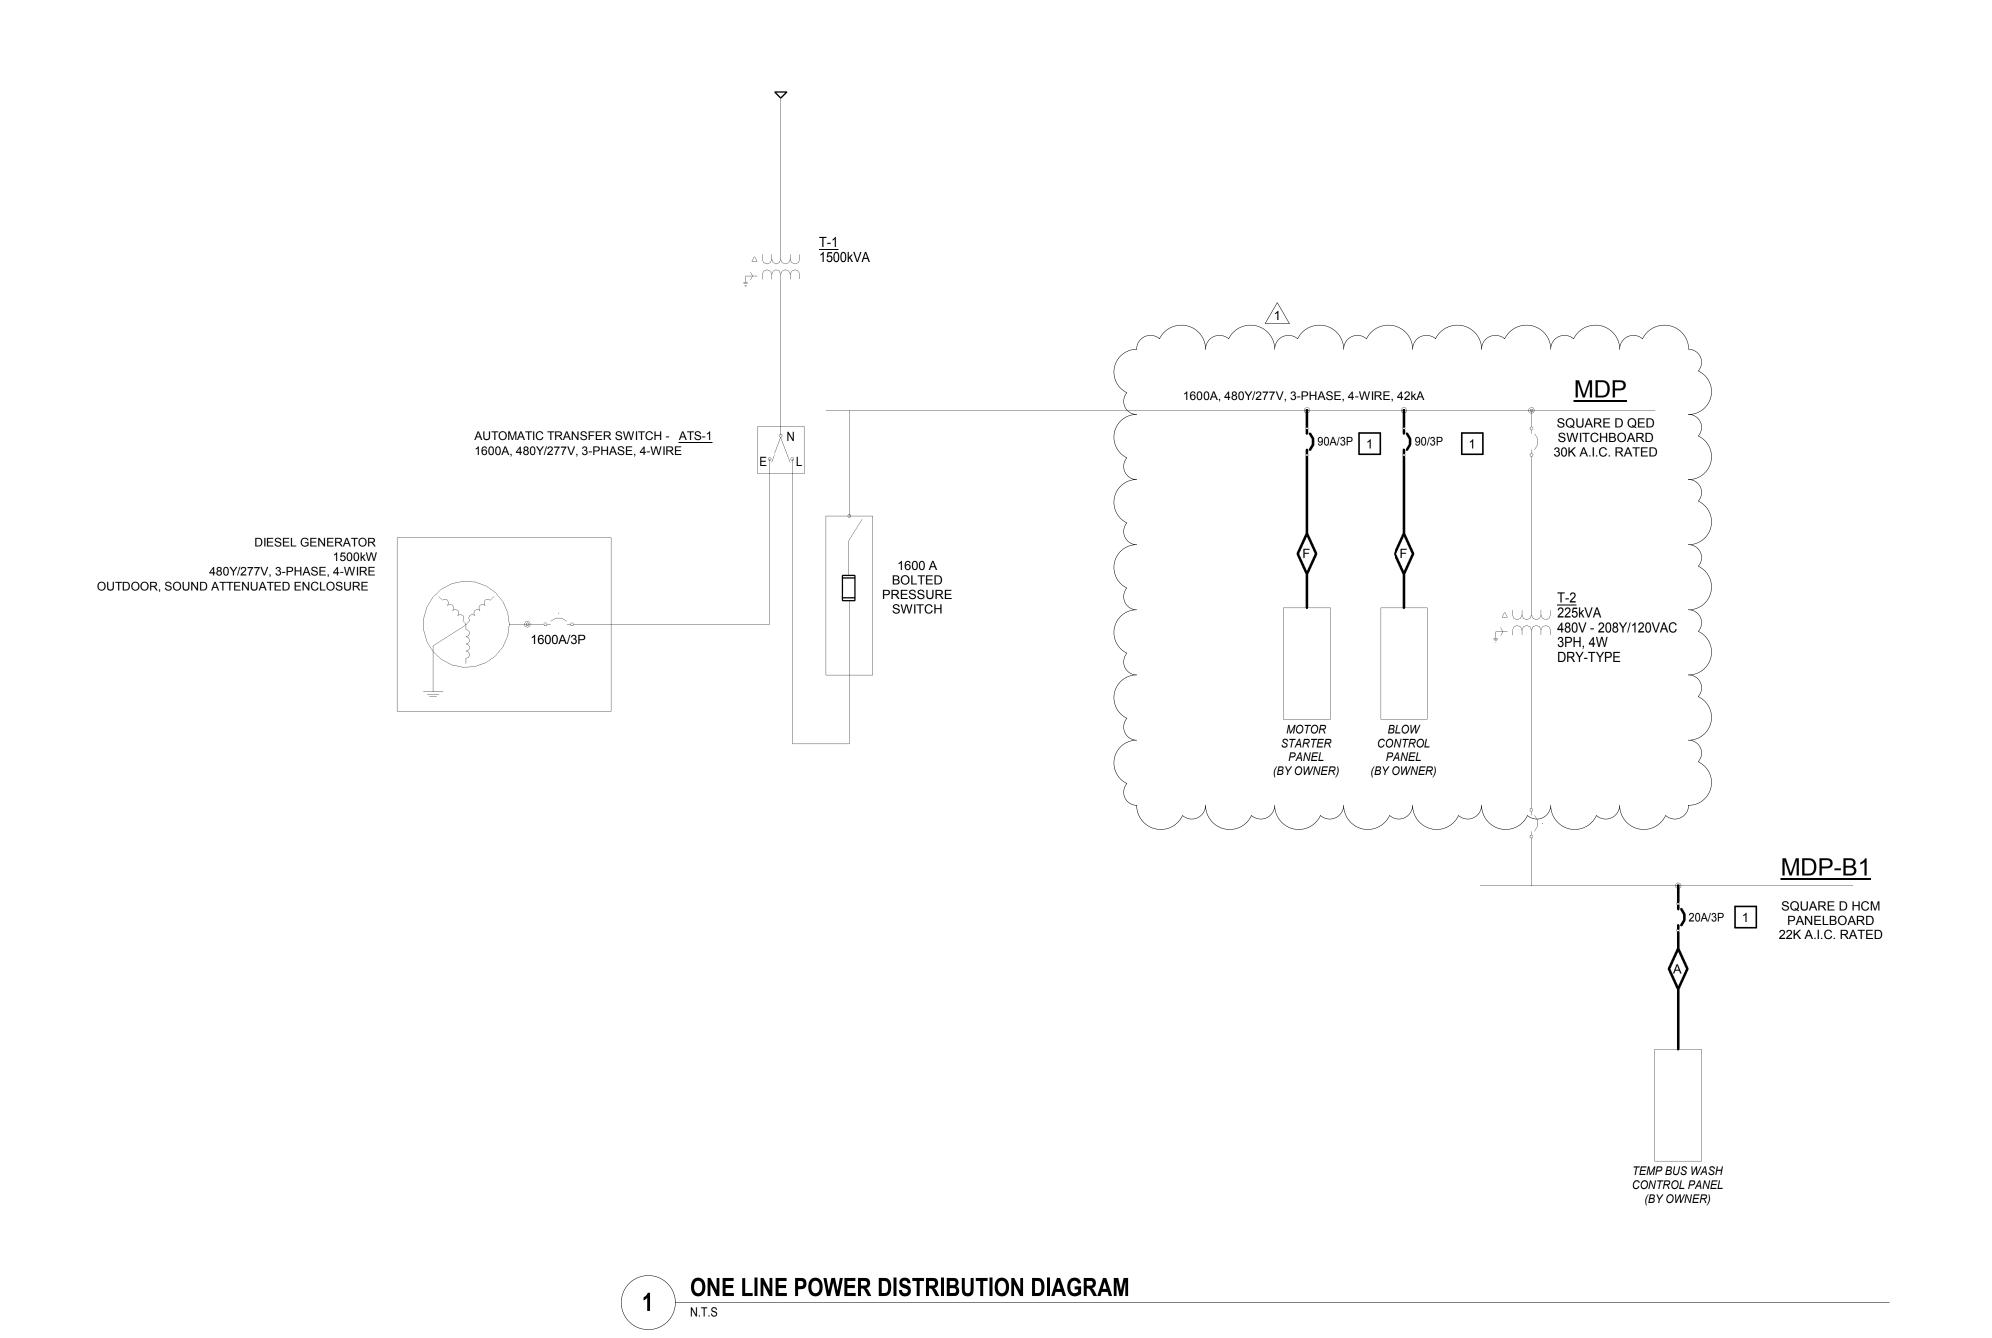

**CONSTRUCTION NOTES:** 1. PROVIDE NOTED BREAKER IN EXISTING SWITCHBOARD/PANEL

BOARD MATCH EXISTING TYPE AND A.I.C. RATING

**BID SET** 

Greater Peoria Mass Transti District

GROUP

100 WALNUT STREET, SUITE 200

www.f-w.com Engineers | Architects | Surveyors | Scientists

> 375 Essjay Road, Suite 200 Williamsville, NY 14221 www.wendelcompanies.com p:716.688.0766 f:716.625.6825 WENDEL ENGINEERING P.C.

# DATE: DESCRIPTION:

1 10/11/19 ADDENDUM #1

PEORIA, ILLINOIS 61602 (309) 689-9888 / info@f-w.com

CityLink Service Bay Remodel

2105 NE Jefferson Street Peoria, IL 61603

DATE:	08/09/201
DESIGNED:	CDV
DRAWN:	MLI
REVIEWED:	JJI

ONE LINE POWER DISTRIBUTION DIAGRAM

4-WIRE SEPARATELY DERIVED 4-WIRE FEEDERS W/O 3-WIRE FEEDERS WITH WIRE SIZE AWG 4-WIRE FEEDERS WITH SYSTEM FEEDERS GROUNDING EQUIPMENT GROUND ELECTRODE CONDUCTOR 2-1/2" 2-1/2"

FEEDER SIZE SCHEDULE

PROJECT NO.: